

WALTHALL

H 2007

10-13-77

MISSISSIPPI BOARD OF WATER COMMISSIONERS  
416 North State Street  
Jackson, Mississippi 39201

WATER WELL DRILLERS LOG

10-13

date well completed

19

77 *Fitzgerald Well Service*

firm name

Walthall

county well located

LANDOWNER:

*Bernice Mason*

*RR. Tylertown, Miss.*  
(mailing address)

description of formations encountered

from

to

<i>Red clay</i>	0	20
<i>Red sand</i>	20	90
<i>Coarse sand &amp; gravel</i>	90	108

WELL LOCATION:

sec. 13 T 1 N R 9 E

10 miles SSW of Tylertown  
(distance) (direction) (nearest town)

WELL PURPOSE: Home  
(home, irrigation, municipal, industrial)

WELL COMPLETION DATA:

- (1) diameter (inches) 4
- (2) total depth (feet) 108
- (3) static water level (feet) 84 below top of ground.
- (4) casing PVC 100  
(material) (depth)  
4 If telescope see back.  
(size)
- (5) screen 8 100  
(length) (depth to top)  
4 PVC  
(size) (material)
- (6) pump 1/2 20  
(HP) (yield gpm)  
Electric  
(type power)
- (7) electric log no  
(yes or no)  
Landstar  
(organization running log)
- (8) how well bottom plugged Small Star


DRILLERS REMARKS:

RECEIVED  
OCT 31 1977

MISS. BD. OF WATER COMMISSIONERS

If well telescopes please sketch and show depths.

GROUND LEVEL

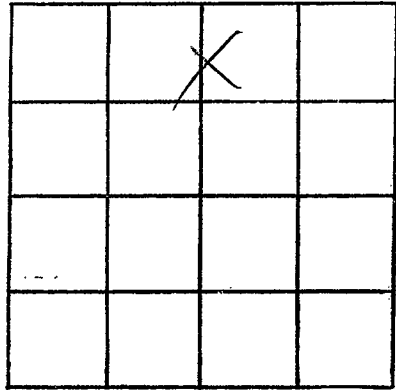

SECTION 13

Please indicate well location X.

ADDITIONAL INFORMATION

If more than one screen, show locations of each on sketch.