

WALTHALL
 H 2000
 6-29-78

MISSISSIPPI
 BOARD OF WATER COMMISSIONERS
 416 North State Street
 Jackson, Mississippi 39201

WATER WELL DRILLERS LOG

6-29 1978 Fitzgerald Well Serv Walthall
 date well completed firm name county well located

LANDOWNER:

Betty Vandann
B.R. of Tylertown
 (mailing address)

description of formations encountered

from to

White Sand 2 15
Coarse sand & gravel 15 95

WELL LOCATION:

sec. 28 T-1 N R-10 E
 S W
8 miles SW of Tylertown
 (distance) (direction) (nearest town)

WELL PURPOSE:

Home
 (home, irrigation, municipal, industrial)

WELL COMPLETION DATA:

- (1) diameter (inches) 4
- (2) total depth (feet) 95
- (3) static water level (feet) 15 below above top of ground.
- (4) casing PVC, 8.7,
 (material) (depth)
4 If telescope see back.
 (size)
- (5) screen 8, 8.7
 (length) (depth to top)
4, PVC
 (size) (material)
- (6) pump 1/2, 15
 (HP) (yield gpm)
electric
 (type power)
- (7) electric log no
 (yes or no)

(organization running log)

(8) how well bottom plugged Sand plug

DRILLERS REMARKS:


RECEIVED
 ALL

AUG 14 1978

MISS. BD. OF WATER COMMISSIONERS

If well telescopes please sketch and show depths.

GROUND LEVEL

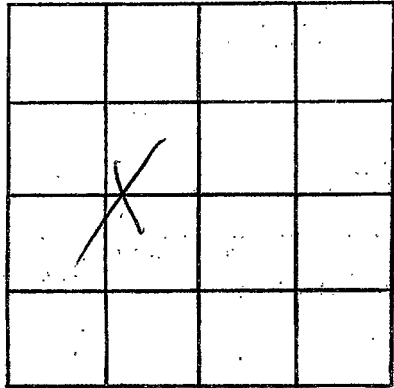

SECTION 28

Please indicate well location X.

ADDITIONAL INFORMATION

If more than one screen,
show locations of each on sketch.