

WALTHALL
H <u>2009</u>
<u>6/17/78</u>

MISSISSIPPI
BOARD OF WATER COMMISSIONERS
416 North State Street
Jackson, Mississippi 39201

WATER WELL DRILLERS LOG

6-17

1978 ~~July 17th~~

Walthall

date well completed

firm name

county well located

Anthony Woodward well drill

LANDOWNER: Dr. Morgan
City
Tylertown, Miss.
(mailing address)

description of formations encountered	from	to
<u>Sand & Gravel</u>	<u>0</u>	<u>46'</u>
<u>White clay</u>	<u>46</u>	<u>58'</u>
<u>Sand & gravel</u>	<u>58</u>	<u>126'</u>
<u>Blue Clay</u>	<u>126</u>	<u>170</u>
<u>Sand</u>	<u>170</u>	<u>185'</u>


WELL LOCATION:
sec 28 T 1 N R 10 E
1/2 miles East of Dillon
(distance) (direction) (nearest town)

WELL PURPOSE: Campground
(home, irrigation, municipal, industrial)

WELL COMPLETION DATA:

- (1) diameter (inches) 2
- (2) total depth (feet) 180
- (3) static water level (feet) 15 below top of ground.
- (4) casing 2" PVC, 135'
(material) (depth)
- 2" if telescope see back.
(size)
- (5) screen None
(length) (depth to top)
- (size) (material)
- (6) pump None 150
(HP) (yield gpm)
- (type power)
- (7) electric log no
(yes or no)
- (organization running log)
- (8) how well bottom plugged


DRILLERS REMARKS:

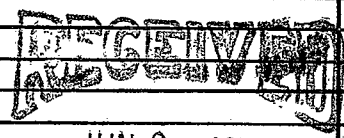

JUN 23 1978

If well telescopes please sketch and show depths.

GROUND LEVEL

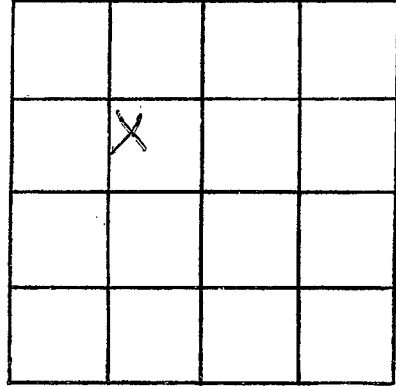

SECTION 28

Please indicate well location X.

ADDITIONAL INFORMATION

If more than one screen,
show locations of each on sketch.