

WALTHALL
H 200
7-30-78

MISSISSIPPI
BOARD OF WATER COMMISSIONERS
416 North State Street
Jackson, Mississippi 39201

WATER WELL DRILLERS LOG

7-30 19 78 *Stallwell Inc* *Walthall*
date well completed firm name county well located


LANDOWNER:	description of formations encountered	from	to
<i>Bruce McCaffery</i> <i>B.R. Talbot</i> (mailing address)			
WELL LOCATION: sec. <u>19</u> T. <u>1</u> N S R. <u>10</u> E W <u>8</u> miles <u>SW</u> of <u>Yule</u> (distance) (direction) (nearest town)			
WELL PURPOSE: (home, irrigation, municipal, industrial)			
WELL COMPLETION DATA:			
(1) diameter (inches) <u>4</u>			
(2) total depth (feet) <u>110</u>			
(3) static water level (feet) <u>50</u> below above top of ground.			
(4) casing <u>PVC 102</u> (material) (depth) <u>4</u> (size) If telescope see back.			
(5) screen <u>8</u> <u>102</u> (length) (depth to top) <u>4</u> <u>PVC</u> (size) (material)			
(6) pump <u>1/2</u> <u>10</u> (HP) (yield gpm) <u>ale</u> (type power)			
(7) electric log <u>yes</u> (yes or no) (organization running log)			
(8) how well bottom plugged <u>Sand</u>			
DRILLERS REMARKS:			

RECEIVED
AUG 14 1978

MISS. BD. OF WATER COMM

If well telescopes please sketch and show depths.

GROUND LEVEL

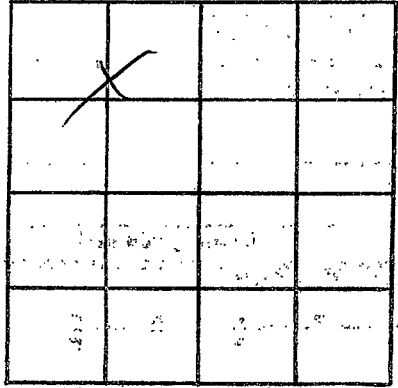

SECTION 19

Please indicate well location X.

ADDITIONAL INFORMATION

If more than one screen,
show locations of each on sketch.