

WALTHALL

H 2011

10-13-78

MISSISSIPPI  
 BOARD OF WATER COMMISSIONERS  
 416 North State Street  
 Jackson, Mississippi 39201

WATER WELL DRILLERS LOG

10-13

date well completed

1978 Fitzgerald Well Serv

firm name

Walthall

county well located

LANDOWNER:

Jim Ward

R.R. Tylertown

(mailing address)

description of formations encountered

from

to

Red clay

0 20

Red sand

20 85

White clay

85 120

Coarse sand & gravel

120 130

WELL LOCATION:

sec. 31 T-1 N R-10 E  
 S W  
12 miles SSW of Tylertown  
 (distance) (direction) (nearest town)

WELL PURPOSE:

Home (home, irrigation, municipal, industrial)

WELL COMPLETION DATA:

- (1) diameter (inches) 4
- (2) total depth (feet) 130
- (3) static water level (feet) 85 below above-top of ground.
- (4) casing PVC, 122  
 (material) (depth)  
4 if telescope see back.  
 (size)
- (5) screen 8, 122  
 (length) (depth to top)  
4, PVC  
 (size) (material)
- (6) pump 1/2, 10  
 (HP) (yield gpm)  
Elco  
 (type power)
- (7) electric log no  
 (yes or no)

(organization running log)

(8) how well bottom plugged fair


DRILLERS REMARKS:

RECEIVED  
DEC - 7 1978

MISS. BD. OF WATER COMMISSIONERS

If well telescopes please sketch and show depths.

GROUND LEVEL

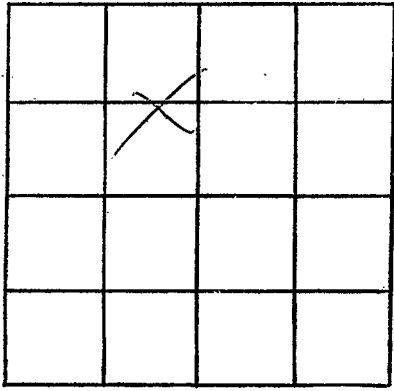

SECTION 31

Please indicate well location X.

ADDITIONAL INFORMATION

Lined area for additional information.

If more than one screen, show locations of each on sketch.