

WALTHALL

H 202

1906-78

MISSISSIPPI BOARD OF WATER COMMISSIONERS
416 North State Street
Jackson, Mississippi 39201

WATER WELL DRILLERS LOG

1-06-79, Folsom Water Well Ser. WALTHALL
date well completed firm name county well located

LANDOWNER: Floyd Hendricks
Folsom, LA. 70437

(mailing address)

WELL LOCATION:

sec. 29 T. 1 N R. 10 E
9 miles SW of Tylertown
(distance) (direction) (nearest town)

WELL PURPOSE: Home-Farm
(home, irrigation, municipal, industrial)

WELL COMPLETION DATA:

- (1) diameter (inches) 4
- (2) total depth (feet) 112
- (3) static water level (feet) 90 below top of ground.
- (4) casing PVC, 102' (material) (depth)
4" (size) if telescope see back.
- (5) screen 10' length, 102' depth to top
4' x .012 PVC (size) (material)
- (6) pump 1 HP, 25 (yield gpm)
230V AC (type power)
- (7) electric log NO (yes or no)

(organization running log)

(8) how well bottom plugged FLOAT
TYPE B.W.V

DRILLERS REMARKS:


description of formations encountered	from	to
SANDY Red CLAY	0	20'
Red SAND	20	32'
LARGE GRAVEL	32	90'
PURPLE CLAY	90	94'
GRAVEL	94	115'

RECEIVED
JAN 10 1979

MISS. BD. OF WATER COMMISSIONERS

If well telescopes please sketch and show depths.

GROUND LEVEL

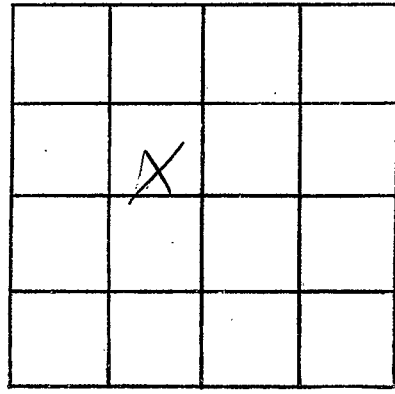

SECTION 29

Please indicate well location X.

ADDITIONAL INFORMATION

Lined area for additional information.

If more than one screen, show locations of each on sketch.