

Walthall
 # H 2016
 7-29-80

MISSISSIPPI
 BOARD OF WATER COMMISSIONERS
 416 North State Street
 Jackson, Mississippi 39201

WATER WELL DRILLERS LOG

WALTHALL

7-29

1980

Fitzgerald Well Serv
 firm name

Pike

date well completed

county well located

LANDOWNER:	description of formations encountered	from	to
Wayne Myers R.R. Tylertown Ms. (mailing address)			
WELL LOCATION:			
sec. 1 T. 10 S. R. 9 E 6 miles SW of Tylertown (distance) (direction) (nearest town)			
WELL PURPOSE: (home, irrigation, municipal, industrial) Home			
WELL COMPLETION DATA:			
(1) diameter (inches) 4			
(2) total depth (feet) 131			
(3) static water level (feet) 55 below top of ground.			
(4) casing PVC 123 (material), (depth) 4 (size) if telescope see back.			
(5) screen 8 123 (length), (depth to top) 4 (size), PVC (material)			
(6) pump 1/2 10 (HP), (yield gpm) Elec (type power)			
(7) electric log (yes or no) (organization running log)			
(8) how well bottom plugged			
DRILLERS REMARKS:			


DEPT. OF NATURAL RESOURCES
 BUREAU OF LAND & WATER RESOURCES

SEP 8 - 1980

RECEIVED

If well telescopes please sketch and show depths.

GROUND LEVEL

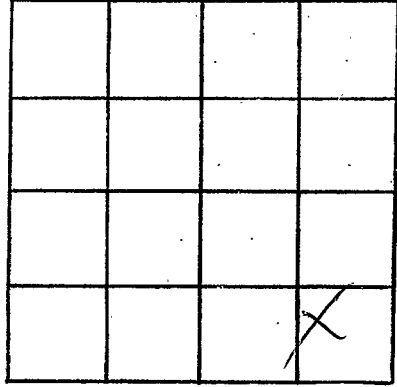

SECTION 1

Please indicate well location X.

ADDITIONAL INFORMATION

If more than one screen, show locations of each on sketch.