

WALTHALL

H 2017

9-23-80

MISSISSIPPI
 BOARD OF WATER COMMISSIONERS.
 416 North State Street
 Jackson, Mississippi 39201

WATER WELL DRILLERS LOG

9-23 1980
date well completed

Interwell Services
firm name

Walthall
county well located

LANDOWNER:

Freel Heack

R.R. Tyltown

(mailing address)

description of formations encountered

from

to

Red Clay	0	20
Red sandstone	20	125
Crine sand & gravel	125	135

WELL LOCATION:

sec. 25 T. 1 N. R. 10 E. 9 ?
 6 miles E of Poyyus
 (distance) (direction) (nearest town)

WELL PURPOSE:

Home
(home, irrigation, municipal, industrial)

WELL COMPLETION DATA:

- (1) diameter (inches) 4
- (2) total depth (feet) 135
- (3) static water level (feet) 89 below top of ground.
- (4) casing PVC, 127 (material), (depth)
 4 (size) If telescope see back.
- (5) screen 8 (length), 127 (depth to top)
 4 (size), PVC (material)
- (6) pump 1/2 (HP), 10 (yield gpm)
 electric (type power)
- (7) electric log yes (yes or no)
 (organization running log)
- (8) how well bottom plugged Sol Well

DEPT. OF NATURAL RESOURCES
BUREAU OF LAND & WATER RESOURCES


DRILLERS REMARKS:

DEC - 9 1980

RECEIVED

If well telescopes please sketch and show depths.

GROUND LEVEL

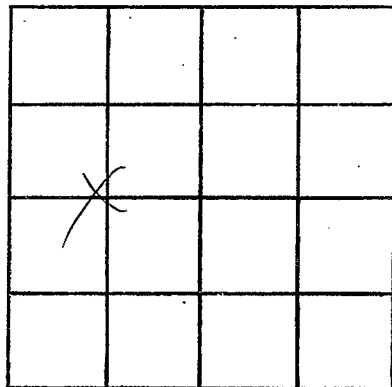

SECTION 25

Please indicate well location X.

ADDITIONAL INFORMATION

If more than one screen,
show locations of each on sketch.