

Walthell
H 2018
1-9-80

MISSISSIPPI
 BOARD OF WATER COMMISSIONERS
 416 North State Street
 Jackson, Mississippi 39201

WATER WELL DRILLERS LOG

4-9 1980 Fitzwell Drilling Walthell
 date well completed firm name county well located

LANDOWNER:	description of formations encountered	from	to
<u>Robert Jean Dann</u>			
<u>Rh. Tyler town</u> (mailing address)	<u>Red clay</u>	<u>0</u>	<u>20</u>
	<u>Red Chalk</u>	<u>20</u>	<u>60</u>
	<u>Coarse Sand & gravel</u>	<u>60</u>	<u>83</u>
WELL LOCATION:			
sec. <u>29</u> T. <u>1</u> N. R. <u>10</u> E S			
<u>10</u> miles <u>S</u> of <u>Tyler</u> (distance) (direction) (nearest town)			
WELL PURPOSE: <u>Home</u> (home, irrigation, municipal, industrial)			
WELL COMPLETION DATA:			
(1) diameter (inches) <u>4</u>			
(2) total depth (feet) <u>83</u>			
(3) static water level (feet) <u>50</u> below top of ground.			
(4) casing <u>PVC</u> , <u>75</u> , (material) (depth) <u>4</u> if telescope see back. (size)			
(5) screen <u>8</u> , <u>75</u> (length) (depth to top) <u>4</u> , <u>PVC</u> (size) (material)			
(6) pump <u>1/2</u> , <u>10</u> (HP) (yield gpm) <u>Electric</u> (type power)			
(7) electric log <u>no</u> (yes or no) (organization running log)			
(8) how well bottom plugged <u>Sand thick</u>			
DRILLERS REMARKS:			


DEPT. OF NATURAL RESOURCES
 BUREAU OF LAND & WATER RESOURCES

JUN 20 1980

RECEIVED

If well telescopes please sketch and show depths.

GROUND LEVEL

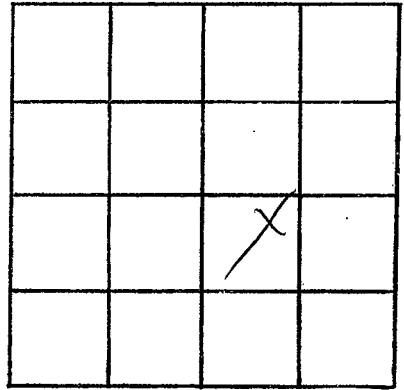

SECTION 39

Please indicate well location X.

ADDITIONAL INFORMATION

If more than one screen,
show locations of each on sketch.