

Walthall  
H 2000  
2-20-80

MISSISSIPPI  
BOARD OF WATER COMMISSIONERS  
416 North State Street  
Jackson, Mississippi 39201

WATER WELL DRILLERS LOG

2-20-1980 date well completed  
Fitzgerald Well Serv firm name  
Walthall county well located

LANDOWNER:

Willie White

R.R. Tylutown  
(mailing address)

WELL LOCATION:

sec. 19 T. 1 N. R. 10 E.  
S W  
8 miles E of Prosser  
(distance) (direction) (nearest town)

WELL PURPOSE: Home  
(home, irrigation, municipal, industrial)

WELL COMPLETION DATA:

- (1) diameter (inches) 4
- (2) total depth (feet) 131
- (3) static water level (feet) 96 below above top of ground.
- (4) casing PVC, 123, (material) (depth)  
4 (size) if telescope see back.
- (5) screen 8, 123 (length) (depth to top)  
4 (size), PVC (material)
- (6) pump 1/2, 10 (HP) (yield gpm)  
ele (type power)
- (7) electric log No (yes or no)

(organization running log)

(8) how well bottom plugged sand slt

description of formations encountered

from to

Red clay	0	20
Red sandstone	20	120
Coarse sand & gravel	120	131

DEPT. OF NATURAL RESOURCES  
BUREAU OF LAND & WATER RESOURCES


MAR 25 1980

DRILLERS REMARKS:

RECEIVED

If well telescopes please sketch and show depths.

GROUND LEVEL

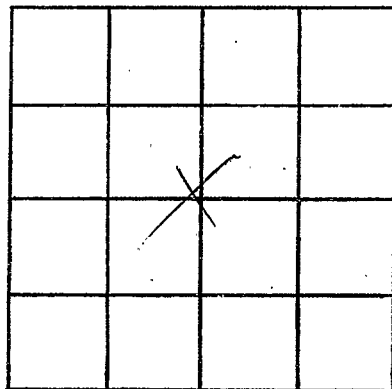

SECTION 19

Please indicate well location X.

ADDITIONAL INFORMATION

If more than one screen,  
show locations of each on sketch.