


Walthall
H 2021
6-8-81

MISSISSIPPI
BOARD OF WATER COMMISSIONERS
416 North State Street
Jackson, Mississippi 39201

WATER WELL DRILLERS LOG


6-8 1981 Fitzgerald Well Service Walthall
date well completed firm name county well located

LANDOWNER:	description of formations encountered	from	to
<u>Robert Fagan</u>			
<u>RR. Lytleton</u> (mailing address)	<u>Red Clay</u> <u>Coarse sand & gravel</u>	<u>0</u> <u>20</u>	<u>20</u> <u>59</u>
WELL LOCATION:			
sec. <u>18</u> T <u>1</u> N R <u>10</u> E S W			
<u>1</u> miles <u>W</u> <u>STALLANS</u> (distance) (direction) (nearest town)			
WELL PURPOSE: <u>Flow</u> (home, irrigation, municipal, industrial)			
WELL COMPLETION DATA:			
(1) diameter (inches) <u>4</u>			
(2) total depth (feet) <u>59</u>			
(3) static water level (feet) <u>38</u> below top of ground.			
(4) casing <u>2 1/2</u> <u>51</u> (material) (depth) <u>4</u> if telescope see back. (size)			
(5) screen <u>8</u> <u>51</u> (length) (depth to top) <u>4</u> <u>2 1/2</u> (size) (material)			
(6) pump <u>1/2</u> <u>10</u> (HP) (yield gpm) <u>EW</u> (type power)			
(7) electric log <u>no</u> (yes or no) (organization running log)			
(8) how well bottom plugged: <u>bedrock</u>			
DRILLERS REMARKS:			

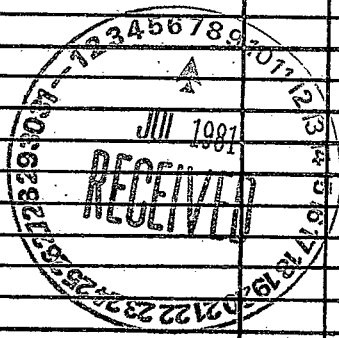

If well telescopes please sketch and show depths.

GROUND LEVEL

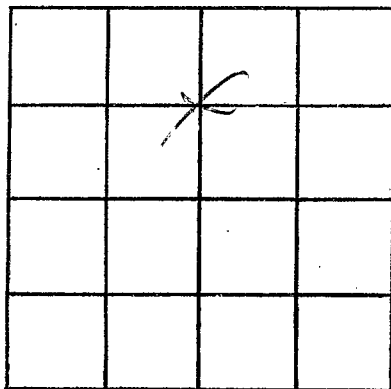

SECTION 16

Please indicate well location X.

ADDITIONAL INFORMATION

If more than one screen,
show locations of each on sketch.