

WALTHALL
 H 2022
 10-1-81

MISSISSIPPI
 BOARD OF WATER COMMISSIONERS
 416 North State Street
 Jackson, Mississippi 39201

WATER WELL DRILLERS LOG

10-1 1981 Fitzgerald Well Serv Walthall
 date well completed firm name county well located

LANDOWNER:
Billy Boyed
R.R. Tolbert
 (mailing address)

description of formations encountered	from	to
<u>Red clay</u>	<u>0</u>	<u>10</u>
<u>Red sand</u>	<u>10</u>	<u>20</u>
<u>Coarse sandstone</u>	<u>20</u>	<u>30</u>

WELL LOCATION:
 sec. 27T 1N 5S R. 10E W
4 miles S of Julie
 (distance) (direction) (nearest town)

WELL PURPOSE: Home
 (home, irrigation, municipal, industrial)

- WELL COMPLETION DATA:
- diameter (inches) 4
 - total depth (feet) 30
 - static water level (feet) 12 below above top of ground.
 - casing PVC, 22,
 (material) (depth)
4
 (size) If telescope see back.
 - screen 8, 22
 (length) (depth to top)
4, PVC
 (size) (material)
 - pump 1/2 10
 (HP) (yield gpm)
blue
 (type power)
 - electric log No
 (yes or no)
 (organization running log)
 - how well bottom plugged Seal block

DEPT. OF NATURAL RESOURCES
 BUREAU OF LAND & WATER RESOURCES


NOV 20 1981

DRILLERS REMARKS:

RECEIVED

If well telescopes please sketch and show depths.

GROUND LEVEL

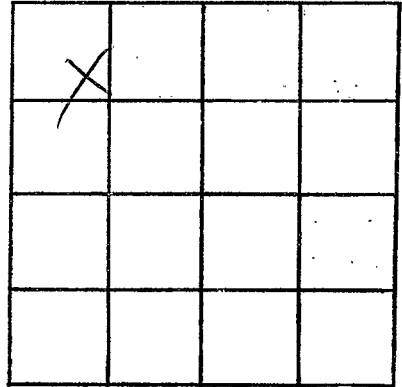

SECTION 37

Please indicate well location X.

ADDITIONAL INFORMATION

If more than one screen,
show locations of each on sketch.