

WALTHALL
H 2023
2-13-81

MISSISSIPPI
BOARD OF WATER COMMISSIONERS
416 North State Street
Jackson, Mississippi 39201

WATER WELL DRILLERS LOG

2-13 1981 F. Small Well Serv Walthall
date well completed firm name county well located

LANDOWNER:	description of formations encountered	from	to
<u>ms. Dale Rayborn</u>			
<u>R.R. Lytleman</u> (mailing address)	<u>Red Clay</u>	<u>0</u>	<u>20</u>
	<u>Red Sand</u>	<u>20</u>	<u>70</u>
	<u>White Clay</u>	<u>70</u>	<u>170</u>
	<u>Coarse Sand & gravel</u>	<u>170</u>	<u>184</u>
WELL LOCATION: sec. <u>36</u> T <u>1N</u> R <u>1E</u> S W			
<u>5</u> miles <u>S</u> of <u>Lytleman</u> (distance) (direction) (nearest town)			
WELL PURPOSE: <u>Home</u> (home, irrigation, municipal, industrial)			
WELL COMPLETION DATA:			
(1) diameter (inches) <u>4</u>			
(2) total depth (feet) <u>184</u>			
(3) static water level (feet) <u>90</u> below above top of ground.			
(4) casing <u>PVC, 176</u> , (material) (depth) <u>4</u> (size) If telescope see back.			
(5) screen <u>8</u> , <u>176</u> (length) (depth to top) <u>4</u> , <u>PVC</u> (size) (material)			
(6) pump <u>3/4</u> , <u>15</u> (HP) (yield gpm) <u>Elva</u> (type power)			
(7) electric log <u>No</u> (yes or no) <u>(organization running log)</u>			
(8) how well bottom plugged <u>Sand Shk</u>			

DEPT. OF NATURAL RESOURCES
BUREAU OF LAND & WATER RESOURCES


APR 28 1981

RECEIVED

DRILLERS REMARKS:

If well telescopes please sketch and show depths.

GROUND LEVEL

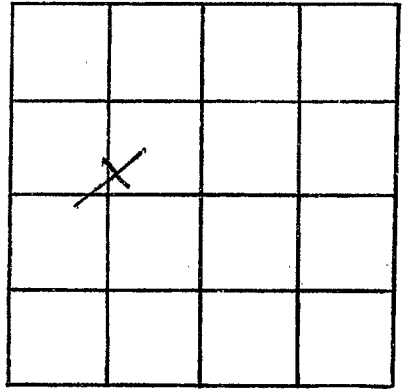

SECTION 36

Please indicate well location X.

ADDITIONAL INFORMATION

If more than one screen, show locations of each on sketch.