

Walthall  
H.  
2025

MISSISSIPPI  
BOARD OF WATER COMMISSIONERS  
416 North State Street  
Jackson, Mississippi 39201

WATER WELL DRILLERS LOG

6-2 date well completed      82 Fitzgerald Well Sew firm name      Walthall county well located

LANDOWNER:  
Vernon Holmes  
R.R. Tylertown  
(mailing address)

description of formations encountered	from	to
Red clay	0	15
White blue clay	15	170
Coarse sandstone	170	185

WELL LOCATION:  
sec. 2 T. 1 N. R. 16 E.  
S. W.  
1/4 miles S of Lumberton  
(distance) (direction) (nearest town)

WELL PURPOSE: Home  
(home, irrigation, municipal, industrial)


- WELL COMPLETION DATA:
- (1) diameter (inches) 4
  - (2) total depth (feet) 185
  - (3) static water level (feet) 10 below above top of ground.
  - (4) casing PVC, 177, (material) (depth)  
4 (size) if telescope see back.
  - (5) screen 8, 177 (length) (depth to top)  
4 (size) PVC (material)
  - (6) pump None, 5 (HP) (yield gpm)  
Flow (type power)
  - (7) electric log No (yes or no)  
(organization running log)
  - (8) how well bottom plugged Sealed

DRILLERS REMARKS:

DEPT. OF NATURAL RESOURCES  
BUREAU OF LAND & WATER RESOURCES  
JUL - 7 1982  
RECEIVED

If well telescopes please sketch and show depths.

GROUND LEVEL

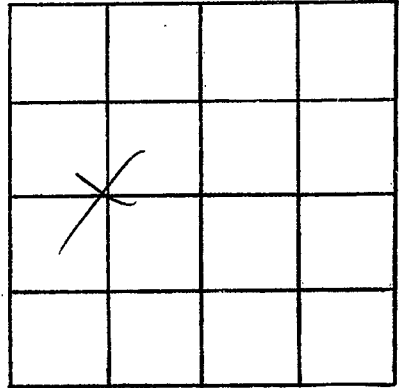

SECTION 2

Please indicate well location X.

ADDITIONAL INFORMATION

If more than one screen, show locations of each on sketch.