

Walthall

H 2020

MISSISSIPPI BOARD OF WATER COMMISSIONERS 416 North State Street Jackson, Mississippi 39201

WATER WELL DRILLERS LOG

Dec. 29, 1983 date well completed Rept Cotton Water Well Sec. firm name Walthall county well located

LANDOWNER: Shirley Smith Mega's Creek Lg. Miss. Rt. 6 (mailing address)

description of formations encountered	from	to
Clay on top	20'	
sand + gravel	20'	
Clay from	40'	200'
flow sand	30'	on bottom

WELL LOCATION: sec. 33 T 10 S R 10 W 10 miles S of Lg. (distance) (direction) (nearest town)

WELL PURPOSE: (home Irrigation municipal, industrial)

WELL COMPLETION DATA:

- (1) diameter (inches) 2 1/2 flow
- (2) total depth (feet) 230
- (3) static water level (feet) flow below top of ground.
- (4) casing 2 in. PVC (material) (depth)
- (5) screen 20 ft. (length) (depth to top) (size) (material)
- (6) pump none (HP) 2 in. full pipe (yield gpm)
- (7) electric log (yes or no)

DEPT. OF NATURAL RESOURCES BUREAU OF LAND & WATER RESOURCES

FEB - 1 1984

RECEIVED


(organization running log)

(8) how well bottom plugged Lin. ball wash valve

DRILLERS REMARKS: Plenty of good water

If well telescopes please  
sketch and show depths.

GROUND LEVEL

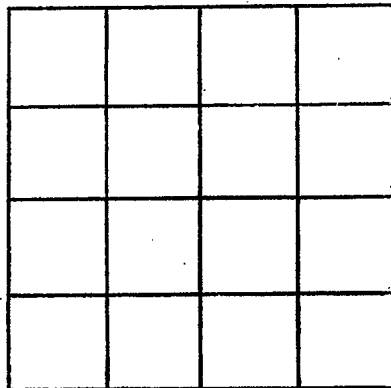

SECTION \_\_\_\_\_

Please indicate well location X.

ADDITIONAL INFORMATION

If more than one screen,  
show locations of each on sketch.