

Walthall  
H 3037

MISSISSIPPI  
BOARD OF WATER COMMISSIONERS  
416 North State Street  
Jackson, Mississippi 39201

WATER WELL DRILLERS LOG

11-11-83 19 *Hoffman Wells Co* firm name *Walthall Co* county well located  
date well completed

LANDOWNER: *Ereth Pope*  
*Jylentown, Miss*  
(mailing address)

WELL LOCATION:  
sec. *2* T. *N* R. *10* E  
*2* miles *South* of *Jylentown*  
(distance) (direction) (nearest town)

WELL PURPOSE: *Home + Irrigation*  
(home, irrigation, municipal, industrial)

- WELL COMPLETION DATA:
- (1) diameter (inches) *2 x 4*
  - (2) total depth (feet) *425 ft.*
  - (3) static water level (feet) *8* below above top of ground.
  - (4) casing *Plastic* *405*  
(material) (depth)  
*40' 4" top* *2" bottom*  
(size) If telescope see back.
  - (5) screen *20 ft.* *405*  
(length) (depth to top)  
*2"* *Plastic*  
(size) (material)
  - (6) pump *1/2* *14*  
(HP) (yield gpm)  
*elect.*  
(type power)
  - (7) electric log  (yes or no)
  - (8) how well bottom plugged *BWU*

description of formations encountered	from	to
<i>top soil</i>	<i>0</i>	<i>2</i>
<i>hard clay</i>	<i>2</i>	<i>20</i>
<i>sand + gravel</i>	<i>20</i>	<i>38</i>
<i>white chalk</i>	<i>38</i>	<i>190</i>
<i>sand</i>	<i>190</i>	<i>240</i>
<i>white chalk</i>	<i>240</i>	<i>360</i>
<i>sand</i>	<i>360</i>	<i>400</i>
<i>sand + gravel</i>	<i>400</i>	<i>425</i>

DEPT. OF NATURAL RESOURCES  
BUREAU OF LAND & WATER RESOURCES


JAN 23 1984

RECEIVED

DRILLERS REMARKS:  
*[Signature]*

If well telescopes please sketch and show depths.

GROUND LEVEL

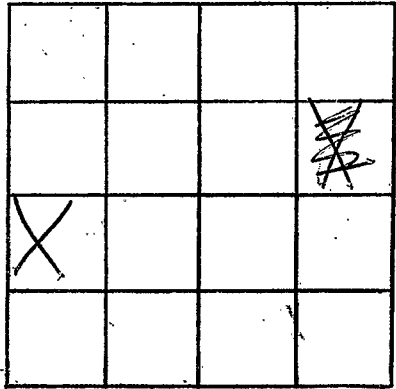

SECTION 2

Please indicate well location X.

ADDITIONAL INFORMATION

If more than one screen,  
show locations of each on sketch.