

MISSISSIPPI DEPARTMENT OF NATURAL RESOURCES

Bureau of Land and Water Resources

Southport Mall

P.O. Box 10631

Jackson, Mississippi 39209

WATER WELL DRILLERS LOG

Walthall  
H 2008

11-4  
date well completed

1983 F. L. Gumbrell, Inc.  
firm name

Walthall  
county well located

LANDOWNER:  
Dale Brock  
P.R. Lytle, owner  
(mailing address)

description of formations encountered	from	to
<u>Red clay</u>	<u>0</u>	<u>20</u>
<u>Red sand</u>	<u>20</u>	<u>100</u>
<u>Coarse sand &amp; gravel</u>	<u>100</u>	<u>115</u>

WELL LOCATION:  
sec. 29 T. 1 N. R. 10 E  
S W  
9 miles S of Lytle  
(distance) (direction) (nearest town)

WELL PURPOSE:  
(home, irrigation, municipal, industrial)

WELL COMPLETION DATA:

- (1) diameter (inches) 4
- (2) total depth (feet) 115
- (3) static water level (feet) 45 below above top of ground.
- (4) casing PVC, 107,  
(material) (depth)  
4 if telescope see back.  
(size)
- (5) screen 8, 107  
(length) (depth to top)  
4, PVC  
(size) (material)
- (6) pump 1/2, 10  
(HP) (yield gpm)  
elec  
(type power)
- (7) electric log no  
(yes or no)  
(organization running log)
- (8) how well bottom plugged fair

DEPT. OF NATURAL RESOURCES  
BUREAU OF LAND & WATER RESOURCES


DEC - 9 1983

RECEIVED

DRILLERS REMARKS:

If well telescopes please  
sketch and show depths.

GROUND LEVEL

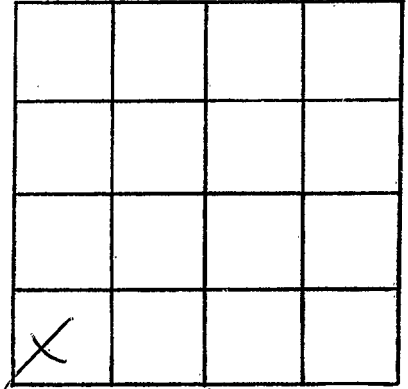

SECTION 29

Please indicate well location X.

ADDITIONAL INFORMATION

If more than one screen,  
show locations of each on sketch.