

Walsh
~~Walsh~~
 H 2008

MISSISSIPPI
 BOARD OF WATER COMMISSIONERS
 416 North State Street
 Jackson, Mississippi 39201

WATER WELL DRILLERS LOG

Walsh

7-23
 date well completed

19 83 Filgueira and Son
 firm name

county well located

LANDOWNER:	description of formations encountered	from	to
<u>Charles Toth</u>			
<u>R.R. Lyubovics, Jr.</u> (mailing address)	<u>Red Clay</u>	<u>0</u>	<u>20</u>
	<u>Red Sand</u>	<u>20</u>	<u>70</u>
	<u>Coarse Sand & gravel</u>	<u>70</u>	<u>85</u>
WELL LOCATION:			
sec. <u>31</u> T <u>1</u> N R <u>10</u> E S			
<u>4</u> miles <u>NW</u> of <u>WARRINGTON</u> (distance) (direction) (nearest town)			
WELL PURPOSE: (home, irrigation, municipal, industrial)			
<u>flow</u>			
WELL COMPLETION DATA:			
(1) diameter (inches) <u>4</u>			
(2) total depth (feet) <u>85</u>			
(3) static water level (feet) <u>35</u> below top of ground. above			
(4) casing <u>PVC</u> , <u>77</u> , (material) (depth) <u>4</u> (size) if telescope see back.			
(5) screen <u>3</u> , <u>77</u> (length) (depth to top) <u>4</u> , <u>PVC</u> (size) (material)			
(6) pump <u>1/2</u> , <u>10</u> (HP) (yield gpm) <u>Electric</u> (type power)			
(7) electric log <u>No</u> (yes or no)			
(organization running log)			
(8) how well bottom plugged <u>Sealed</u>			
DRILLERS REMARKS:			


DEPT. OF NATURAL RESOURCES
 BUREAU OF LAND & WATER RESOURCES

AUG 15 1983

RECEIVED

If well telescopes please sketch and show depths.

GROUND LEVEL

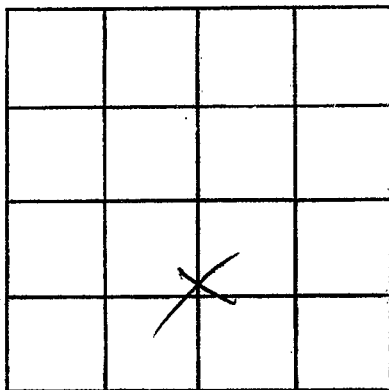

SECTION 31

Please indicate well location X.

ADDITIONAL INFORMATION

If more than one screen, show locations of each on sketch.