

Walshall
H 2030

MISSISSIPPI
 BOARD OF WATER COMMISSIONERS
 416 North State Street
 Jackson, Mississippi 39201

WATER WELL DRILLERS LOG

Walshall
Boke

7-22 1983 F. General well Inc
 date well completed firm name county well located

LANDOWNER:	description of formations encountered	from	to
<u>Gary Bunk</u>			
<u>P.R. Lytle</u> (mailing address)	<u>Red clay</u>	<u>0</u>	<u>20</u>
	<u>Red sand</u>	<u>20</u>	<u>50</u>
	<u>Blue chalk</u>	<u>50</u>	<u>180</u>
	<u>Coarse sand & gravel</u>	<u>180</u>	<u>196</u>
WELL LOCATION:			
sec <u>20</u> T <u>1</u> N R <u>10</u> E S W			
<u>12</u> miles <u>S</u> of <u>Walshall</u> (distance) (direction) (nearest town)			
WELL PURPOSE: (home, irrigation, municipal, industrial)			
<u>Home</u>			
WELL COMPLETION DATA:			
(1) diameter (inches) <u>4</u>			
(2) total depth (feet) <u>196</u>			
(3) static water level (feet) <u>55</u> below top of ground. above			
(4) casing <u>PVC</u> , <u>188</u> , (material) (depth)			
<u>4</u> (size) if telescope see back.			
(5) screen <u>8</u> , <u>188</u> (length) (depth to top)			
<u>4</u> , <u>PVC</u> (size) (material)			
(6) pump <u>1</u> , <u>70</u> (HP) (yield gpm)			
<u>Electric</u> (type power)			
(7) electric log <u>no</u> (yes or no)			
<u>Walshall</u> (organization running log)			
(8) how well bottom plugged <u>Walshall</u>			
DRILLERS REMARKS:			


DEPT. OF NATURAL RESOURCES
 BUREAU OF LAND & WATER RESOURCES

AUG 15 1983

RECEIVED

If well telescopes please sketch and show depths.

GROUND LEVEL

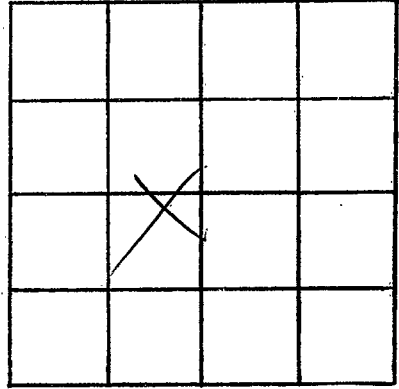

SECTION 20

Please indicate well location X.

ADDITIONAL INFORMATION

If more than one screen,
show locations of each on sketch.