

Walthall
H
2032

MISSISSIPPI DEPARTMENT OF NATURAL RESOURCES
Bureau of Land and Water Resources
Southport Mall
P.O. Box 10631
Jackson, Mississippi 39209
WATER WELL DRILLERS LOG

5-13-1983 date well completed
Fitzgerald Well Serv firm name
Walthall county well located

LANDOWNER:	description of formations encountered	from	to
A. J. Raybon P.O. Lytleton (mailing address)	Red clay course sand gravel	0 20	20 126
WELL LOCATION: sec. 25 T-1 N R-10 E S W 8 miles ESE of Lytleton (distance) (direction) (nearest town)			
WELL PURPOSE: (home, irrigation, municipal, industrial) Home			
WELL COMPLETION DATA:			
(1) diameter (inches) 4			
(2) total depth (feet) 126			
(3) static water level (feet) 60 below above top of ground.			
(4) casing PVC 116 (material) (depth)			
4 (size) if telescope see back.			
(5) screen 10 116 (length) (depth to top)			
4 (size) PVC (material)			
(6) pump 1 25 (HP) (yield gpm)			
Electric (type power)			
(7) electric log Yes (yes or no)			
(organization running log)			
(8) how well bottom plugged Seal shot			
DRILLERS REMARKS:			


DEPT. OF NATURAL RESOURCES
BUREAU OF LAND & WATER RESOURCES

JUL 11 1983

RECEIVED

If well telescopes please sketch and show depths.

GROUND LEVEL

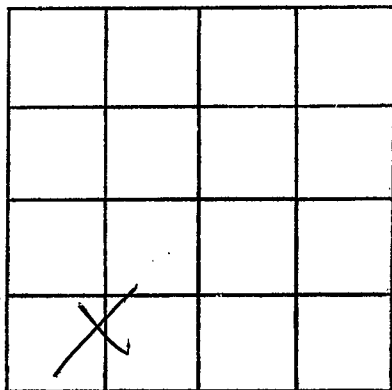

SECTION 25

Please indicate well location X.

ADDITIONAL INFORMATION

If more than one screen,
show locations of each on sketch.