

WATTHAL
~~WATTHAL~~
 H 20354
 11-29-84

MISSISSIPPI
 BOARD OF WATER COMMISSIONERS
 416 North State Street
 Jackson, Mississippi 39201

WATER WELL DRILLERS LOG

11/29/84 date well completed 19 Stopwell Inc. firm name Walthall county well located

LANDOWNER Jo Ann McKeage
Jackson, Miss
 (mailing address)

WELL LOCATION:
 sec. 1 T. 1 N. R. 10 E. S. 5 W.
6 miles (distance) SS/WS (direction) of Jackson (nearest town)

WELL PURPOSE: None
 (home, irrigation, municipal, industrial)

- WELL COMPLETION DATA:
- (1) diameter (inches) 4"
 - (2) total depth (feet) 145'
 - (3) static water level (feet) 90 below above top of ground.
 - (4) casing Plastic (material) 135' (depth)
4" (size) if telescope see back.
 - (5) screen 10' (length) 135' (depth to top)
4" (size) Plastic (material)
 - (6) pump 1 (HP) (yield gpm)
Electric (type power)
 - (7) electric log (yes or no)
 - (8) how well bottom plugged B/W/S

description of formations encountered	from	to
<u>top soil</u>	<u>0</u>	<u>2</u>
<u>red clay</u>	<u>2</u>	<u>40</u>
<u>dry sand & gravel</u>	<u>40</u>	<u>90</u>
<u>white chalk</u>	<u>90</u>	<u>125</u>
<u>sand & gravel</u>	<u>125</u>	<u>145</u>


RECEIVED
 MAR 28 1985

Department of Natural Resources
 Bureau of Land & Water Resources

DRILLERS REMARKS:
Walthall

If well telescopes please sketch and show depths.

GROUND LEVEL

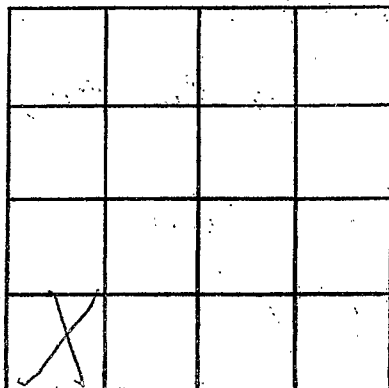

SECTION 1

Please indicate well location X.

ADDITIONAL INFORMATION

If more than one screen, show locations of each on sketch.