

BOARD OF WATER COMMISSIONERS

416 North State Street

Jackson, Mississippi 39201

Walthall
A H
2035

WATER WELL DRILLERS LOG

10-20-84 date well completed
1984 R. Cotton Drilling firm name
Walthall county well located

LANDOWNER	description of formations encountered	from	to
Letha Simmons, Rt. 6	Sand + gravel	0	30'
Box 133, Tylertown, Miss (mailing address)	10' clay	30	40'
	15' water bearing sand	40	55

WELL LOCATION:
 1/2 mi. South of Hwy. 27
 taken on Lemon Rd
 next to railroad
 (distance) (direction) (nearest town)

WELL PURPOSE: Home
 (home, irrigation, municipal, industrial)

WELL COMPLETION DATA:

- (1) diameter (inches) 4 in.
- (2) total depth (feet) 55'
- (3) static water level (feet) 15' below top of ground.
- (4) casing Sc. 40, 55 (material) (depth)
- (size) if telescope see back.
- (5) screen 10' (length) (depth to top)
4" (size) ple (material)
- (6) pump 1/2 (HP) 800 (yield gpm)
220 (type power)
- (7) electric log (yes or no)
- (organization running log)
- (8) how well bottom plugged b.w. valve


DRILLERS REMARKS: Good well
Plenty water

DEPT. OF NATURAL RESOURCES
BUREAU OF LAND & WATER RESOURCES

OCT 29 1984
RECEIVED

If well telescopes please sketch and show depths.

GROUND LEVEL

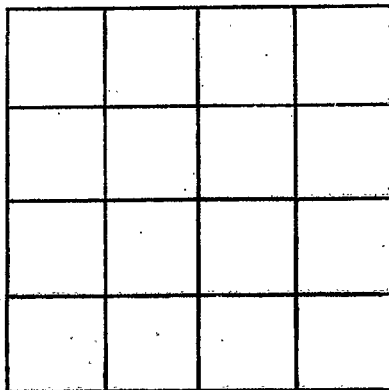

SECTION _____

Please indicate well location X.

ADDITIONAL INFORMATION

If more than one screen,
show locations of each on sketch.