

WALTHALL
H 2036

MISSISSIPPI DEPARTMENT OF NATURAL RESOURCES
Bureau of Land and Water Resources
Southport Mall
P.O. Box 10631
Jackson, Mississippi 39209
WATER WELL DRILLERS LOG

June 12 1984 Runs well for Walthall
date well completed firm name county well located

LANDOWNER:
Ren Miller
Mt Lyketown
(mailing address)

description of formations encountered	from	to
Clay	0	20
Sand & Gravel	20	40
Red Chalk	40	83
Red sand	83	123
Coarse sand	123	127

WELL LOCATION:
sec 30 T 1 N R 10 E
7 miles S-SW of Lyketown
(distance) (direction) (nearest town)

WELL PURPOSE: Trade
(home, irrigation, municipal, industrial)

- WELL COMPLETION DATA:
- (1) diameter (inches) 4"
 - (2) total depth (feet) 127
 - (3) static water level (feet) 75 below top of ground.
 - (4) casing plastic bottom
(material) (depth)
 - (5) screen 6' 127'
(length) (depth to top)
 - (6) pump 6" plastic
(size) (material)
 - (7) pump 1/2 HP
(HP) (yield gpm)
 - (8) electric log NO
(yes or no)
 - (9) (organization running log)
 - (10) how well bottom plugged back wash

DEPT. OF NATURAL RESOURCES
BUREAU OF LAND & WATER RESOURCES


JUL 20 1984

RECEIVED

DRILLERS REMARKS:

If well telescopes please sketch and show depths.

GROUND LEVEL

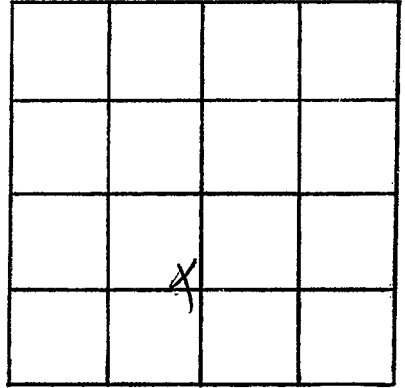

SECTION 30

Please indicate well location X.

ADDITIONAL INFORMATION

If more than one screen,
show locations of each on sketch.