

MISSISSIPPI DEPARTMENT OF NATURAL RESOURCES

Bureau of Land and Water Resources

Southport Mall

P.O. Box 10631

Jackson, Mississippi 39209

WATER WELL DRILLERS LOG

Waltheil
H 2037

R-10
date well completed

1984

Fitzgibbon well Co
firm name

Waltheil
county well located

LANDOWNER:	description of formations encountered	from	to
<u>B. J. Lyon</u> <u>P.O. Magnolia ms.</u> (mailing address)	<u>Reel Clay</u> <u>Reel Sand</u> <u>Coarse sand & gravel</u>	<u>0</u> <u>20</u> <u>130</u>	<u>20</u> <u>130</u> <u>140</u>
<p>WELL LOCATION:</p> <p>sec. <u>12</u> T <u>1</u> N R <u>10</u> E S W</p> <p><u>3</u> miles <u>S</u> of <u>Wheeler</u> (distance) (direction) (nearest town)</p>			
<p>WELL PURPOSE: <u>Home</u> (home, irrigation, municipal, industrial)</p>			
<p>WELL COMPLETION DATA:</p> <p>(1) diameter (inches) <u>4</u></p> <p>(2) total depth (feet) <u>140</u></p> <p>(3) static water level (feet) <u>97</u> below above top of ground.</p> <p>(4) casing <u>PVC, 132</u> (material) (depth) <u>4</u> if telescope see back. (size)</p> <p>(5) screen <u>8, 132</u> (length) (depth to top) <u>4</u>, <u>PVC</u> (size) (material)</p> <p>(6) pump <u>1/2, 10</u> (HP) (yield gpm) <u>elec</u> (type power)</p> <p>(7) electric log <u>no</u> (yes or no) <u>(organization running log)</u></p> <p>(8) how well bottom plugged <u>Sealed</u></p>			

DEPT. OF NATURAL RESOURCES
BUREAU OF LAND & WATER RESOURCES


MAR - 7 1984

RECEIVED

DRILLERS REMARKS:

If well telescopes please sketch and show depths.

GROUND LEVEL

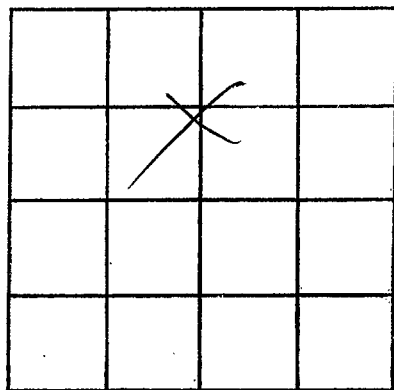

SECTION 12

Please indicate well location X.

ADDITIONAL INFORMATION

If more than one screen,
show locations of each on sketch.