

Walthell  
H 2038

MISSISSIPPI  
BOARD OF WATER COMMISSIONERS  
416 North State Street  
Jackson, Mississippi 39201

WATER WELL DRILLERS LOG

3/22/84 19 Ralph Cotton Water Well Sec.  
date well completed firm name county well located  
Orme from G. South

LANDOWNER: Dr. Magee  
Rt. 7 Box 237 B  
Igleitown, Miss.  
(mailing address)

description of formations encountered	from	to
<u>Clay</u>		
<u>Clay + sand</u>	<u>60ft.</u>	
<u>Water bearing sand</u>	<u>60</u>	<u>87</u>

WELL LOCATION:  
sec. 36 T 10 N R 100  
4 miles N of Thomas  
(distance) (direction) (nearest town)

WELL PURPOSE:  
(home, irrigation, municipal, industrial)

- WELL COMPLETION DATA:
- (1) diameter (inches) 4 in.
  - (2) total depth (feet) 87 ft.
  - (3) static water level (feet) 60 below above top of ground.
  - (4) casing 4 in. P.V.C. 87  
(material) (depth)  
(size) if telescope see back.
  - (5) screen 10 ft. 87  
(length) (depth to top)  
SC 40 plastic  
(size) (material)
  - (6) pump 1/2 1,000 gpm.  
(HP) (yield gpm)  
1150.  
(type power)
  - (7) electric log (yes or no)

(organization running log)

(8) how well bottom plugged sand  
Shack Drive

DRILLERS REMARKS: a  
good well


DEPT. OF NATURAL RESOURCES  
BUREAU OF LAND & WATER RESOURCES

APR 12 1984

RECEIVED

If well telescopes please sketch and show depths.

GROUND LEVEL

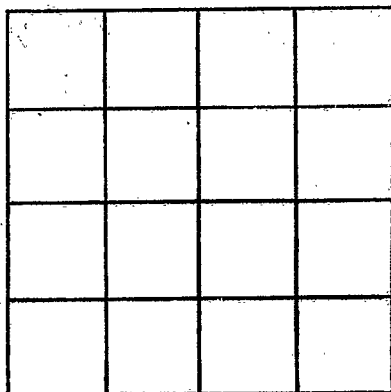

SECTION \_\_\_\_\_

Please indicate well location X.

ADDITIONAL INFORMATION

If more than one screen,  
show locations of each on sketch.