

Walthall
H 2032

MISSISSIPPI
BOARD OF WATER COMMISSIONERS
416 North State Street
Jackson, Mississippi 39201

WATER WELL DRILLERS LOG

1-3
date well completed

1984

Hooper Hill
Driller name

Walthall
county well located

LANDOWNER: John Whisen Diller

description of formations encountered

from to

Jylertown, Miss
(mailing address)

top soil
red clay

0 1
1 60

WELL LOCATION:

sec. 1 T 1 N R 10 E
9 miles South of Jylertown
(distance) (direction) (nearest town)

red sand
white chalk

60 80
80 110

WELL PURPOSE: Home
(home, irrigation, municipal, industrial)

sand rock
sand

110 112
112 144

WELL COMPLETION DATA:

- (1) diameter (inches) 2 1/2"
- (2) total depth (feet) 154 ft.
- (3) static water level (feet) 80 (below above top of ground)
- (4) casing (material) Plastic (depth) 144 ft.
4" (size) if telescope see back.
- (5) screen 10 ft. 144 ft.
(length) (depth to top)
4" (size) Plastic (material)
- (6) pump 1/2 (HP) 14 (yield gpm)
Elect. (type power)
- (7) electric log (yes or no)

(organization running log)

(8) how well bottom plugged BWR

DRILLERS REMARKS:

[Handwritten signature]


DEPT. OF NATURAL RESOURCES
BUREAU OF LAND & WATER RESOURCES

JAN 23 1984

RECEIVED

If well telescopes please sketch and show depths.

GROUND LEVEL

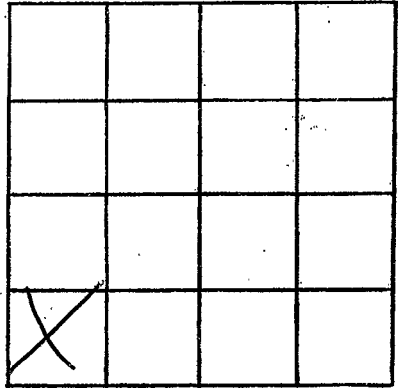

SECTION 1

Please indicate well location X.

ADDITIONAL INFORMATION

If more than one screen,
show locations of each on sketch.