

WALTHALL
H 2041

MISSISSIPPI DEPARTMENT OF NATURAL RESOURCES
Bureau of Land and Water Resources
Southport Mall
P.O. Box 10631
Jackson, Mississippi 39209
WATER WELL DRILLERS LOG

10-23 1986 Fitzgerald Well Serv Walthall
date well completed firm name county well located

LANDOWNER:	description of formations encountered	from	to
<u>Wayne Myers</u> <u>R.R. Lyburtson MS -</u> (mailing address)			
WELL LOCATION:			
sec. <u>23</u> T <u>1</u> N S R <u>10</u> E W			
<u>3</u> miles <u>S</u> of <u>Lexie</u> (distance) (direction) (nearest town)			
WELL PURPOSE: (home, irrigation, municipal, industrial)			
WELL COMPLETION DATA:			
(1) diameter (inches) <u>4</u>			
(2) total depth (feet) <u>24</u>			
(3) static water level (feet) <u>5</u> below top of ground.			
(4) casing <u>pvc</u> , <u>14</u> , (material) (depth) <u>4</u> (size) if telescope see back.			
(5) screen <u>10</u> , <u>14</u> (length) (depth to top) <u>4</u> , <u>pvc</u> (size) (material)			
(6) pump <u>1/2</u> , <u>10</u> (HP) (yield gpm) <u>Elu</u> (type power)			
(7) electric log <u>No</u> (yes or no) <u>Elu</u> (organization running log)			
(8) how well bottom plugged <u>Seal the</u>			

RECEIVED


DEC 08 1986

Department of Natural Resources
Bureau of Land & Water Resources

DRILLERS REMARKS:

If well telescopes please sketch and show depths.

GROUND LEVEL

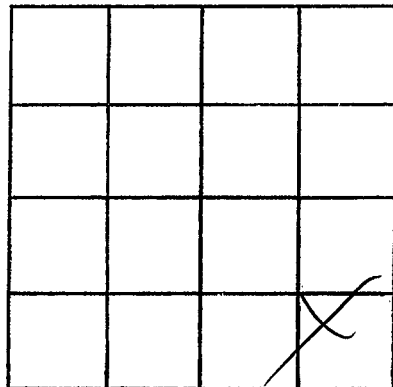

SECTION 22

Please indicate well location X.

ADDITIONAL INFORMATION

If more than one screen,
show locations of each on sketch.