

MISSISSIPPI DEPARTMENT OF NATURAL RESOURCES

Bureau of Land and Water Resources

Southport Mall

P.O. Box 10631


Jackson, Mississippi 39209

WATER WELL DRILLERS LOG

WALTHAM
H 2042

4-11 1986 date well completed
Fitzmaurice Inc firm name
Waltham county well located

LANDOWNER:	description of formations encountered	from	to
Dalton Lueder			
RR. Fitzmaurice Inc. (mailing address)	Red clay Coarse sand & gravel	0	20 31
WELL LOCATION:			
sec. 27 T 38 N R 28 E 14 1 S 10 W			
① miles SE of Levie (distance) (direction) (nearest town)			
WELL PURPOSE: Home (home, irrigation, municipal, industrial)			
WELL COMPLETION DATA:			
(1) diameter (inches) 4			
(2) total depth (feet) 31			
(3) static water level (feet) 15 below above top of ground.			
(4) casing PVC 31 (material) (depth) 4 (size) if telescope see back.			
(5) screen 10 31 (length) (depth to top) 4 PVC (size) (material)			
(6) pump 1/2 10 (HP) (yield gpm) Elec (type power)			
(7) electric log No (yes or no) (organization running log)			
(8) how well bottom plugged Sand			

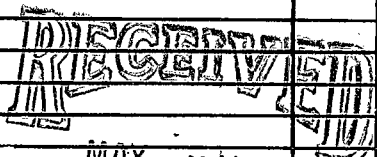


MAY 5 1986

DRILLERS REMARKS:

Department of Natural Resources
Bureau of Land & Water Resources

If well telescopes please sketch and show depths.

GROUND LEVEL

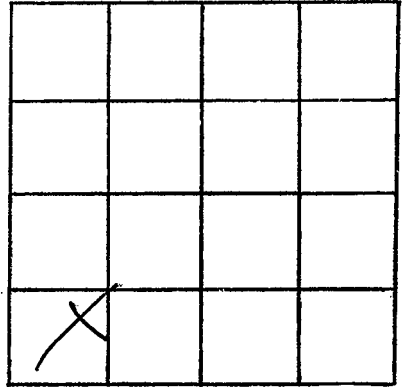

SECTION 14

Please indicate well location X.

ADDITIONAL INFORMATION

If more than one screen,
show locations of each on sketch.