

MISSISSIPPI DEPARTMENT OF NATURAL RESOURCES

Bureau of Land and Water Resources

Southport Mall

P.O. Box 10631

Jackson, Mississippi 39209

WATER WELL DRILLERS LOG

Walthall
H 2045
5/26/89
 date well completed '19

Stops and Wells Walthall
 firm name county well located

LANDOWNER:
Quaine Duncan
 (mailing address)

description of formations encountered	from	to
<u>top soil</u>	<u>0</u>	<u>1</u>
<u>Sandy Clay</u>	<u>1</u>	<u>30</u>
<u>sand</u>	<u>30</u>	<u>70</u>
<u>shale</u>	<u>70</u>	<u>180</u>
<u>sand</u>	<u>180</u>	<u>220</u>

WELL LOCATION:
 sec. 1 T. 1 N. R. 10 E
5 miles South of Lylertown
 (distance) (direction) (nearest town)

WELL PURPOSE: Home
 (home, irrigation, municipal, industrial)

WELL COMPLETION DATA:

(1) diameter (inches) 4"

(2) total depth (feet) 220

(3) static water level (feet) 40 below above top of ground

(4) casing Plastic 210
 (material) (depth)
4"
 (size) if telescope see back.

(5) screen 20 90
 (length) (depth to top)
4 Plastic
 (size) (material)

(6) pump _____
 (HP) (yield gpm)

(type power) _____

(7) electric log _____
 (yes or no)

(organization running log) _____

(8) how well bottom plugged BWU

DRILLERS REMARKS:
[Signature]


RECEIVED

JUN 16 1987

Department of Natural Resources
 Bureau of Land & Water Resources

If well telescopes please sketch and show depths.

GROUND LEVEL

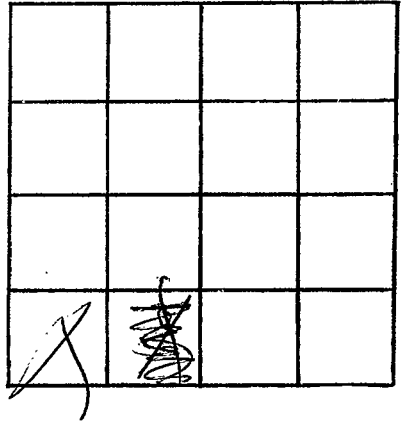

SECTION 1

Please indicate well location X.

ADDITIONAL INFORMATION

If more than one screen,
show locations of each on sketch.