

MISSISSIPPI DEPARTMENT OF NATURAL RESOURCES

Bureau of Land and Water Resources

Southport Mall

P.O. Box 10631

Jackson, Mississippi 39209

WATER WELL DRILLERS LOG

WATSON  
H 2046

5/17/87 19  
 date well completed

Stafford Well Dr.  
 firm name

Walthall  
 county well located

LANDOWNER:  
A. D. Lunnage  
 (mailing address)

description of formations encountered	from	to
<u>top soil</u>	<u>0</u>	<u>1</u>
<u>sandy clay</u>	<u>1</u>	<u>20</u>
<u>gravel</u>	<u>20</u>	<u>50</u>
<u>Shale</u>	<u>50</u>	<u>240</u>
<u>Sand &amp; Gravel</u>	<u>240</u>	<u>296</u>

WELL LOCATION:  
 sec. 1 T. 1 N R. 10 E  
4 miles South of Lyleston  
 (distance) (direction) (nearest town)

WELL PURPOSE: None  
 (home, irrigation, municipal, industrial)

- WELL COMPLETION DATA:
- (1) diameter (inches) 2"
  - (2) total depth (feet) 276
  - (3) static water level (feet) flow below above top of ground.
  - (4) casing Plastic 276  
 (material) (depth)
  - 2" If telescope see back.  
 (size)
  - (5) screen 20 276  
 (length) (depth to top)
  - 2 Plastic  
 (size) (material)
  - (6) pump \_\_\_\_\_  
 (HP) (yield gpm)
  - (type power) \_\_\_\_\_
  - (7) electric log \_\_\_\_\_  
 (yes or no)
  - (organization running log) \_\_\_\_\_
  - (8) how well bottom plugged BWC

**RECEIVED**


JUN 16 1987

Department of Natural Resources  
 Bureau of Land & Water Resources

DRILLERS REMARKS:  
[Signature]

If well telescopes please sketch and show depths.

GROUND LEVEL

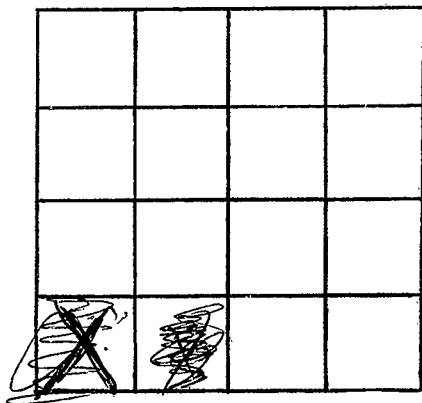

SECTION \_\_\_\_\_

Please indicate well location X.

ADDITIONAL INFORMATION

If more than one screen,  
show locations of each on sketch.