

MISSISSIPPI DEPARTMENT OF NATURAL RESOURCES

Bureau of Land and Water Resources

Southport Mall

P.O. Box 10631

Jackson, Mississippi 39209

WATER WELL DRILLERS LOG

WALTHAM
H 2047

5-4 1987 date well completed
 Fitzgerald Well Co. firm name
 Waltham county well located


LANDOWNER:	description of formations encountered	from	to
Leddie Brock - R.R. Fultons ms. (mailing address)			
WELL LOCATION:			
sec. 30 T. 1 N. R. 10 E S W			
2 miles W of Dillons (distance) (direction) (nearest town)			
WELL PURPOSE: Home (home, irrigation, municipal, industrial)			
WELL COMPLETION DATA:			
(1) diameter (inches) 4			
(2) total depth (feet) 120			
(3) static water level (feet) 42 below above top of ground.			
(4) casing PVC 110 (material) (depth) 4 if telescope see back. (size)			
(5) screen 10 110 (length) (depth to top) 4 PVC (size) (material)			
(6) pump 1/2 10 (HP) (yield gpm) elec (type power)			
(7) electric log no (yes or no) (organization running log)			
(8) how well bottom plugged sandstone			
DRILLERS REMARKS:			

RECEIVED
JUN 15 1987

Department of Natural Resources
Bureau of Land & Water Resources

If well telescopes please sketch and show depths.

GROUND LEVEL

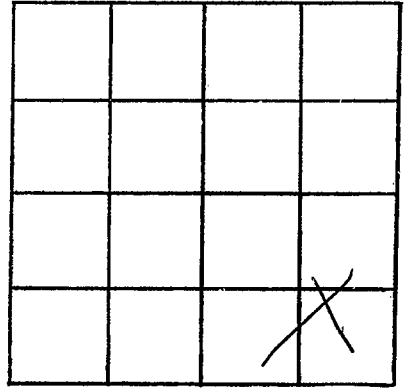

SECTION 30

Please indicate well location X.

ADDITIONAL INFORMATION

If more than one screen,
show locations of each on sketch.