

MISSISSIPPI DEPARTMENT OF NATURAL RESOURCES

Bureau of Land and Water Resources

P.O. Box 10631

Jackson, Mississippi 39209

WATER WELL DRILLERS LOG

COUNTY WELL LOCATED WALTHALL	
WELL NUMBER H	CODED
DATE WELL COMPLETED 2049 1-20-88	

PERMIT NUMBER
NAME OF DRILLING FIRM Brown's Water Well McComb, MS

NAME & MAILING ADDRESS OF LANDOWNER Anstin Deer Rt. 1 Osyka, MS. 39659			
WELL LOCATION: SEC	TOWNSHIP	RANGE	
9	1 S	10 E	
DISTANCE	DIRECTION	NEAREST TOWN	
6 Miles	Ssw	of Tylertown	
OTHER LANDMARK			
WELL PURPOSE: Home, Irrigation, Municipal, Industrial, Fish Pond, etc. CAMP			

PUMP DATA		
PUMP TYPE (Circle One): Submersible, Turbine, Jet, Flowing Well, Other (Describe) hand pump		
POWER TYPE (Circle One): Electric, Tractor, Diesel, Gasoline, Butane, Other (Describe)		
Pump Capacity (GPM)	No. of Stages	Setting Depth FT.
PUMP TEST		
Well yielded 36 GPM with a drawdown of 20 ft. after 2 1/2 hours of pumping		

WELL DATA		
Well Depth 254	Casing Diameter (In.) 2"	Casing Length (Ft.) 235
Type of Casing plastic	Hole Depth 254	Depth to Static Water Level 1' below ground
TYPE OF COMPLETION: (Circle One or More) Gravel Packed, Underreamed, Telescoped, Natural Development , Open Hole, Other (Describe)		
Top of Lap Pipe or Reduction in Casing FEET IF TELESCOPED OR MORE THAN ONE SCREEN: USE BACK PAGE		

LOG DATA	
TYPE OF LOG RUN (Circle One): Electric, Gamma Ray, Density, Sonic, No Log Run , Neutron, Other (Describe)	
Name of Organization Running Log	

SCREEN DATA		
Diameter - Inches 2	Length - Feet 20	Slot Size - Inches 0.12
Screen Type plastic	Depth to Bottom - Feet 255	


GEOLOGIC DATA (Office Use Only)			
Surface Elev.	Geologic Unit	Unit Thickness	Depth to Top
Subs. SWL	Date	Analysis	Aquifer Test
Driller's Remarks <div style="text-align: center; font-size: 2em; font-weight: bold; opacity: 0.5;">RECEIVED</div> APR 12 1988			

DESCRIPTION OF FORMATIONS ENCOUNTERED	FROM	TO	FORMATIONS (Continued)	FROM	TO
Top Soil	0	2'	Department of Natural Resources		
SAND & gravel	2	60'	Bureau of Land & Water	Recorded	
blue & white clay	60'	105'			
fine sand	105'	163'			
COARSE SAND & gravel	163'	255'			

IF MORE SPACE IS NEEDED, USE BACK

If well telescopes please
sketch and show depths.

GROUND LEVEL

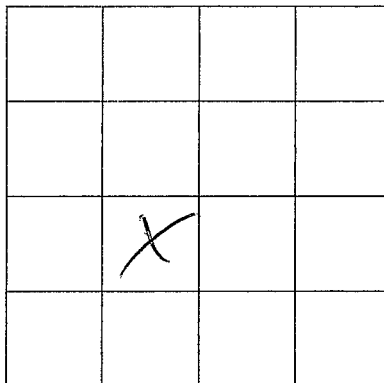

SECTION 9

Please indicate well location X.

ADDITIONAL INFORMATION

If more than one screen,
show location of each on sketch.
