

MISSISSIPPI DEPARTMENT OF NATURAL RESOURCES

Bureau of Land and Water Resources

Southport Mall

P.O. Box 10631

Jackson, Mississippi 39209

WATER WELL DRILLERS LOG

WALTMAN  
H 2058

Nov 29

1989

F. J. Goodland & Son

firm name

Walthall

county well located

LANDOWNER:

Jimmy Hobgood  
R.R. - Tylertown, Miss.  
(mailing address)

description of formations encountered

from

to

<u>Red clay</u>	<u>0</u>	<u>20</u>
<u>white &amp; blue chalk</u>	<u>20</u>	<u>135</u>
<u>green sand &amp; gravel</u>	<u>135</u>	<u>150</u>

WELL LOCATION:

sec. 18 T 1 N R 10 E  
S W  
5 miles WSW of Leke  
(distance) (direction) (nearest town)

WELL PURPOSE: Home  
(home, irrigation, municipal, industrial)

WELL COMPLETION DATA:

- (1) diameter (inches) 4
- (2) total depth (feet) 150
- (3) static water level (feet) 55 below above top of ground.
- (4) casing PVC 1 1/2  
(material) (depth)  
4 If telescope see back.  
(size)
- (5) screen 10 140  
(length) (depth to top)  
4 PVC  
(size) (material)
- (6) pump 1/2 10  
(HP) (yield gpm)  
elec  
(type power)
- (7) electric log No  
(yes or no)  
(organization running log)

(8) how well bottom plugged Sealed


DRILLERS REMARKS:

RECEIVED  
DEC 11 1989

Department of Natural Resources  
Bureau of Land & Water Resources

If well telescopes please sketch and show depths.

GROUND LEVEL

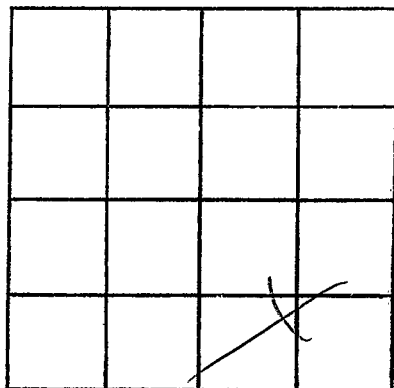

SECTION 18

Please indicate well location X.

ADDITIONAL INFORMATION

If more than one screen,  
show locations of each on sketch.