

MISSISSIPPI DEPARTMENT OF NATURAL RESOURCES

Bureau of Land and Water Resources

P.O. Box 10631

Jackson, Mississippi 39209

WATER WELL DRILLERS LOG

COUNTY WELL LOCATED <i>Walthall</i>	
WELL NUMBER <i>11</i>	CODED
DATE WELL COMPLETED <i>March 8-90</i>	

PERMIT NUMBER
NAME OF DRILLING FIRM <i>F. PALGRAVE Well Serv</i>

NAME & MAILING ADDRESS OF LANDOWNER <i>Sednie Brock</i> <i>R.B. Lyntam, Mrs.</i>		
WELL LOCATION: SEC	TOWNSHIP	RANGE
<i>30</i>	<i>1 N</i>	<i>10 E</i>
DISTANCE	DIRECTION	NEAREST TOWN
<i>7</i> Miles	<i>SE</i>	<i>of Bogans</i>
OTHER LANDMARK		
WELL PURPOSE: Home, Irrigation, Municipal, Industrial, Fish Pond, etc. <i>Home</i>		

PUMP DATA		
PUMP TYPE (Circle One): <input checked="" type="checkbox"/> Submersible, <input type="checkbox"/> Turbine, <input type="checkbox"/> Jet <input type="checkbox"/> Flowing Well, Other (Describe) _____		
POWER TYPE (Circle One): <input checked="" type="checkbox"/> Electric, <input type="checkbox"/> Tractor, <input type="checkbox"/> Diesel, <input type="checkbox"/> Gasoline, <input type="checkbox"/> Butane, Other (Describe) _____ H/P <i>1/2</i>		
Pump Capacity (GPM) <i>10</i>	No. of Stages <i>9</i>	Setting Depth <i>90</i> FT.
PUMP TEST		
Well yielded <i>25</i> GPM with a drawdown of <i>2</i> ft. after <i>2</i> hours of pumping		

WELL DATA		
Well Depth <i>120</i>	Casing Diameter (In.) <i>4</i>	Casing Length (Ft.) <i>110</i>
Type of Casing <i>PVC</i>	Hole Depth <i>120</i>	Depth to Static Water Level <i>62</i>
TYPE OF COMPLETION: (Circle One or More): <input checked="" type="checkbox"/> Gravel Packed, <input type="checkbox"/> Underreamed, <input type="checkbox"/> Telescoped, <input type="checkbox"/> Natural Development, <input type="checkbox"/> Open Hole, <input type="checkbox"/> Other (Describe) _____		
Top of Lap Pipe or Reduction in Casing		
FEET	IF TELESCOPED OR MORE THAN ONE SCREEN: USE BACK PAGE	

LOG DATA	
TYPE OF LOG-RUN (Circle One): <input type="checkbox"/> Electric, <input type="checkbox"/> Gamma Ray, <input type="checkbox"/> Density, <input type="checkbox"/> Sonic, <input type="checkbox"/> Neutron, Other (Describe) _____	
Name of Organization Running Log <i>No Log Run</i>	

SCREEN DATA		
Diameter - Inches <i>4</i>	Length - Feet <i>10</i>	Slot Size - Inches <i>.014</i>
Screen Type <i>PVC</i>	Depth to Bottom - Feet <i>120</i>	

GEOLOGIC DATA (Office Use Only)			
Surface Elev.	Geologic Unit	Unit Thickness	Depth to Top
Subs. SWL	Date	Analysis	Aquifer Test

Driller's Remarks

DESCRIPTION OF FORMATIONS ENCOUNTERED	FROM	TO	FORMATIONS (Continued)	ERQM	TO
<i>Red clay</i>	<i>0</i>	<i>20</i>	RECEIVED APR 06 1990 Department of Natural Resources Bureau of Land & Water Resources		
<i>Red sand</i>	<i>20</i>	<i>104</i>			
<i>Coarse sand & gravel</i>	<i>104</i>	<i>120</i>			

IF MORE SPACE IS NEEDED, USE BACK

If well telescopes please sketch and show depths.


GROUND LEVEL

X			

SECTION 30

Please indicate well location X.

ADDITIONAL INFORMATION

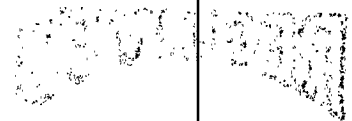

Faint text at the bottom of the page, possibly a footer or disclaimer.

If more than one screen,
show location of each on sketch.