

MISSISSIPPI DEPARTMENT OF ENVIRONMENTAL QUALITY
Bureau of Land and Water Resources

P. O. Box 10631
Jackson, MS 39289-0631
WATER WELL DRILLERS LOG

COUNTY WELL LOCATED <i>Wallkill</i>	
WELL NUMBER <i>H</i>	CODED
DATE WELL COMPLETED <i>May 13-91</i>	

PERMIT NUMBER
NAME OF DRILLING FIRM <i>FITZGERALD Well Serv</i>

NAME & MAILING ADDRESS OF LANDOWNER <i>C. J. Command</i> <i>R.R. Lytleton, ms.</i>		
WELL LOCATION: SEC	TOWNSHIP	RANGE
<i>32</i>	<i>1</i>	<i>N 10 E</i>
DISTANCE	DIRECTION	NEAREST TOWN
<i>1</i> Miles	<i>S</i>	<i>Pillons</i>
OTHER LANDMARK		
WELL PURPOSE: Home, Irrigation, Municipal, Industrial, Fish Pond, etc. <i>Home</i>		

PUMP DATA		
PUMP TYPE (Circle One): <input checked="" type="checkbox"/> Submersible, Turbine, Jet, Flowing Well, Other (Describe) _____		
POWER TYPE (Circle One): <input checked="" type="checkbox"/> Electric, Tractor, Diesel, Gasoline, Butane, Other (Describe) _____ H/P _____		
Pump Capacity (GPM) <i>10</i>	No. of Stages <i>1</i>	Setting Depth <i>32</i> FT.
PUMP TEST		
Well yielded <i>10</i> GPM with a drawdown of <i>1</i> ft. after <i>1</i> hours of pumping		

WELL DATA		
Well Depth <i>98</i>	Casing Diameter (In.) <i>4</i>	Casing Length (Ft.) <i>88</i>
Type of Casing <i>PVC</i>	Hole Depth <i>98</i>	Depth to Static Water Level <i>28</i>
TYPE OF COMPLETION: (Circle One or More): <input checked="" type="checkbox"/> Gravel Packed, <input type="checkbox"/> Underreamed, <input type="checkbox"/> Telescoped, <input type="checkbox"/> Natural Development, <input type="checkbox"/> Open Hole, <input type="checkbox"/> Other (Describe) _____		
Top of Lap Pipe or Reduction in Casing		
FEET IF TELESCOPED OR MORE THAN ONE SCREEN: USE BACK PAGE		

LOG DATA	
TYPE OF LOG RUN (Circle One): Electric, Gamma Ray, Density, Sonic, Neutron, Other (Describe) _____ <input checked="" type="checkbox"/> No Log Run	
Name of Organization Running Log	

SCREEN DATA		
Diameter - Inches <i>4</i>	Length - Feet <i>10</i>	Slot Size - Inches <i>1014</i>
Screen Type <i>PVC</i>	Depth to Bottom - Feet <i>98</i>	


GEOLOGIC DATA (Office Use Only)			
Surface Elev.	Geologic Unit	Unit Thickness	Depth to Top
Subs. SWL	Date	Analysis	Aquifer Test
Driller's Remarks			

DESCRIPTION OF FORMATIONS ENCOUNTERED	FROM	TO
<i>Red clay</i>	<i>0</i>	<i>74</i>
<i>Wash Bank</i>	<i>14</i>	<i>25</i>
<i>Red Clay</i>	<i>25</i>	<i>87</i>
<i>Orange fault g.</i>	<i>87</i>	<i>98</i>

FORMATIONS (Continued)	FROM	TO
<i>Red Clay</i>	<i>0</i>	<i>74</i>
<i>Wash Bank</i>	<i>14</i>	<i>25</i>
<i>Red Clay</i>	<i>25</i>	<i>87</i>
<i>Orange fault g.</i>	<i>87</i>	<i>98</i>
MAY 23 1991		
Dept. of Environmental Quality Bureau of Land & Water Resources		
IF MORE SPACE IS NEEDED, USE BACK		

If well telescopes please sketch and show depths.

GROUND LEVEL

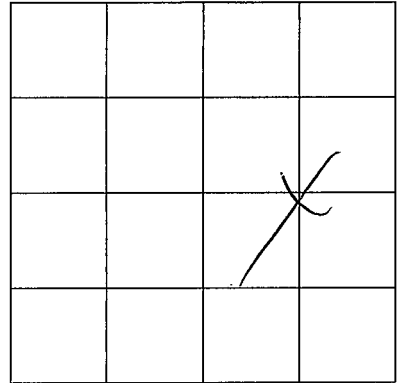

SECTION 32

Please indicate well location X.

ADDITIONAL INFORMATION

If more than one screen,
show location of each on sketch.