

**MISSISSIPPI DEPARTMENT OF ENVIRONMENTAL QUALITY**

Office of Land and Water Resources

P. O. Box 10631  
Jackson, MS 39289-0631  
**WATER WELL DRILLERS LOG**

COUNTY WELL LOCATED <i>WALSH</i>	
WELL NUMBER <i>H</i>	CODED
DATE WELL COMPLETED <i>August 17-92</i>	

PERMIT NUMBER
NAME OF DRILLING FIRM <i>FITZGERALD Well Serv</i>

NAME & MAILING ADDRESS OF LANDOWNER <i>BRENDA FASBENDER</i> <i>R.R. Lytle town Ms.</i>		
WELL LOCATION: SEC	TOWNSHIP	RANGE
<i>11</i>	<i>1</i>	<i>N 10 E</i>
DISTANCE	DIRECTION	NEAREST TOWN
<i>1</i> Miles	<i>E</i> of	<i>Lexie</i>
OTHER LANDMARK		
WELL PURPOSE: Home, Irrigation, Municipal, Industrial, Fish Pond, etc. <i>Home</i>		

PUMP DATA		
PUMP TYPE (Circle One): <u>Submersible</u> , Turbine, Jet, Flowing Well, Other (Describe)		
POWER TYPE (Circle One): <u>Electric</u> , Tractor, Diesel, Gasoline, Butane, Other (Describe) <i>H/P 1/2</i>		
Pump Capacity (GPM) <i>10</i>	No. of Stages <i>8</i>	Setting Depth <i>45</i> FT.
PUMP TEST		
Well yielded <i>10</i> GPM with a drawdown of <i>5</i> ft. after <i>1</i> hours of pumping		

WELL DATA		
Well Depth <i>60</i>	Casing Diameter (in.) <i>4</i>	Casing Length (Ft.) <i>50</i>
Type of Casing <i>PVC</i>	Hole Depth <i>60</i>	Depth to Static Water Level <i>10</i>

LOG DATA	
TYPE OF LOG RUN (Circle One): Electric, Gamma Ray, Density, Sonic, Neutron, Other (Describe) <u>No Log Run</u>	
Name of Organization Running Log	

TYPE OF COMPLETION: (Circle One or More): <u>Gravel Packed</u> , Underreamed, Telescoped, Natural Development, Open Hole, Other (Describe)	
---	--

WELL GROUTED TO A DEPTH OF <i>10</i> FEET Type Grout (circle one): Cement, Bentonite, or Mix
---

GEOLOGIC DATA (Office Use Only)			
Surface Elev.	Geologic Unit	Unit Thickness	Depth to Top
Subs. SWL	Date	Analysis	Aquifer Test

SCREEN DATA		
Diameter - Inches <i>4</i>	Length - Feet <i>10</i>	Slot Size - Inches <i>.014</i>
Screen Type <i>PVC</i>	Depth to Bottom - Feet <i>60</i>	

Driller's Remarks
<b>RECEIVED</b>


DESCRIPTION OF FORMATIONS ENCOUNTERED	FROM	TO
<i>Top Soil &amp; SAND</i>	<i>0</i>	<i>15</i>
<i>white clay</i>	<i>15</i>	<i>42</i>
<i>Coarse Sand</i>	<i>42</i>	<i>60</i>

FORMATIONS (Continued)	FROM	TO
<b>SEP 01 1992</b>		
Dept. of Environmental Quality Bureau of Land & Water Resources		

IF MORE SPACE IS NEEDED, USE BACK

If well telescopes please sketch and show depths.

GROUND LEVEL

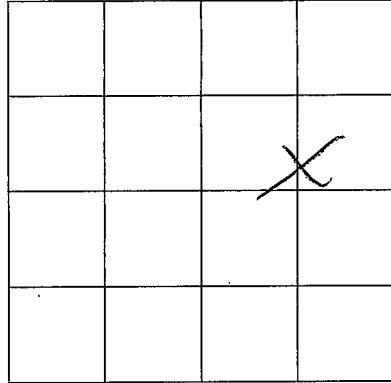

SECTION 11

Please indicate well location X.

ADDITIONAL INFORMATION

If more than one screen,  
show location of each on sketch.