

MISSISSIPPI DEPARTMENT OF ENVIRONMENTAL QUALITY

Office of Land and Water Resources

P. O. Box 10631
Jackson, MS 39289-0631
WATER WELL DRILLERS LOG

COUNTY WELL LOCATED <i>Wall</i>	
WELL NUMBER H	CODED
DATE WELL COMPLETED 2073 <i>Oct 6, 92</i>	

PERMIT NUMBER
NAME OF DRILLING FIRM <i>FILBERMAN Well Serv</i>

NAME & MAILING ADDRESS OF LANDOWNER <i>Wilmon Van Dorn</i> <i>B.R., Lumberton MS.</i>			
WELL LOCATION: SEC	TOWNSHIP	RANGE	
<i>28</i>	<i>1</i>	<i>N</i> <i>S</i>	<i>10</i> E W
DISTANCE	DIRECTION	NEAREST TOWN	
<i>2</i> Miles	<i>S</i>	of <i>Merle</i>	
OTHER LANDMARK			
WELL PURPOSE: Home Irrigation, Municipal, Industrial, Fish Pond, etc. <i>Home</i>			

PUMP DATA		
PUMP TYPE (Circle One): <u>Submersible</u> Turbine, Jet, Flowing Well, Other (Describe)		
POWER TYPE (Circle One): <u>Electric</u> , Tractor, Diesel, Gasoline, Butane, Other (Describe) <i>H/P 12</i>		
Pump Capacity (GPM) <i>10</i>	No. of Stages <i>8</i>	Setting Depth FT.
PUMP TEST		
Well yielded <i>15</i> GPM with a drawdown of <i>3</i> ft. after <i>2</i> hours of pumping		

WELL DATA		
Well Depth <i>95</i>	Casing Diameter (In.) <i>4</i>	Casing Length (Ft.) <i>85</i>
Type of Casing <i>MVC</i>	Hole Depth <i>95</i>	Depth to Static Water Level <i>20</i>
TYPE OF COMPLETION: (Circle One or More): <u>Gravel Packed</u> , Underreamed, Telescoped, Natural Development, Open Hole, Other (Describe)		

LOG DATA	
TYPE OF LOG RUN (Circle One): <u>No Log Run</u> , Electric, Gamma Ray, Density, Sonic, Neutron, Other (Describe)	
Name of Organization Running Log	

WELL GROUTED TO A DEPTH OF <i>10</i> FEET Type Grout (circle one): Cement, Bentonite, or Mix

GEOLOGIC DATA (Office Use Only)			
Surface Elev.	Geologic Unit	Unit Thickness	Depth to Top
Subs. SWL	Date	Analysis	Aquifer Test

SCREEN DATA		
Diameter - Inches <i>7</i>	Length - Feet <i>10</i>	Slot Size - Inches <i>1014</i>
Screen Type <i>MVC</i>	Depth to Bottom - Feet <i>95</i>	


Driller's Remarks

DESCRIPTION OF FORMATIONS ENCOUNTERED	FROM	TO	FORMATIONS (Continued)	FROM	TO
<i>Red clay</i>	<i>0</i>	<i>10</i>	RECEIVED DEC 07 1992 Dept. of Environmental Quality Bureau of Land & Water Resources		
<i>Rite sand</i>	<i>10</i>	<i>80</i>			
<i>Course SAND & GRAVEL</i>	<i>80</i>	<i>95</i>			

IF MORE SPACE IS NEEDED, USE BACK

If well telescopes please sketch and show depths.

GROUND LEVEL

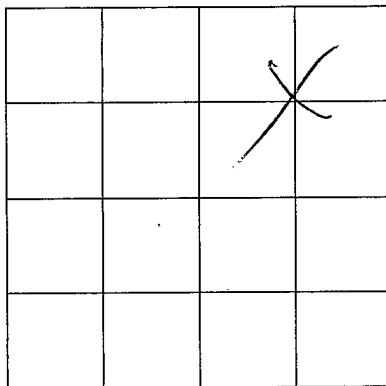

SECTION _____

Please indicate well location X.

ADDITIONAL INFORMATION

If more than one screen,
show location of each on sketch.