

MISSISSIPPI DEPARTMENT OF ENVIRONMENTAL QUALITY

Office of Land and Water Resources

P. O. Box 10631  
Jackson, MS 39289-0631  
WATER WELL DRILLERS LOG

COUNTY WELL LOCATED  
*Walthall*

WELL NUMBER *14* CODED

DATE WELL COMPLETED  
*2014*  
*Oct 22-92*

PERMIT NUMBER

NAME OF DRILLING FIRM  
*Fitzgerald Well Serv*

NAME & MAILING ADDRESS OF LANDOWNER  
*Clifton Humphrey*  
*R.B. Glatton ms.*

WELL LOCATION: SEC *10* TOWNSHIP *1* RANGE *10* *N* *E*  
*S* *W*

DISTANCE *1* Miles DIRECTION *S* NEAREST TOWN *Devie*

OTHER LANDMARK

WELL PURPOSE: Home, Irrigation, Municipal, Industrial, Fish Pond, etc.  
*Home*

PUMP DATA

PUMP TYPE (Circle One):  
 Submersible, Turbine, Jet, Flowing Well,  
Other (Describe)

POWER TYPE (Circle One):  
 Electric, Tractor, Diesel, Gasoline, Butane,  
Other (Describe) *H/P 1/2*

Pump Capacity (GPM) No. of Stages Setting Depth

PUMP TEST

Well yielded *20* GPM with  
a drawdown of *2* ft.  
after *2* hours of pumping

WELL DATA

Well Depth <i>120</i>	Casing Diameter (In.) <i>4</i>	Casing Length (Ft.) <i>110</i>
Type of Casing <i>PVC</i>	Hole Depth <i>120</i>	Depth to Static Water Level <i>27</i>

TYPE OF COMPLETION: (Circle One or More):  
 Gravel Packed, Underreamed, Telescoped,  
 Natural Development, Open Hole, Other  
(Describe)

LOG DATA

TYPE OF LOG RUN (Circle One):  
Electric, Gamma Ray, Density, Sonic, Neutron,  
Other (Describe) *No Log Run*

Name of Organization Running Log

WELL GROUTED TO A DEPTH OF *10* FEET  
Type Grout (circle one): Cement, Bentonite, or Mix

GEOLOGIC DATA (Office Use Only)

Surface Elev.	Geologic Unit	Unit Thickness	Depth to Top
Subs. SWL	Date	Analysis	Aquifer Test

SCREEN DATA

Diameter - Inches <i>4</i>	Length - Feet <i>10</i>	Slot Size - Inches <i>1014</i>
Screen Type <i>PVC</i>	Depth to Bottom - Feet <i>120</i>	


Driller's Remarks

DESCRIPTION OF FORMATIONS ENCOUNTERED	FROM	TO	FORMATIONS ENCOUNTERED FROM TO
<i>Red Clay</i>	<i>0</i>	<i>20</i>	<b>RECEIVED</b> DEC 07 1992 Dept. of Environmental Quality Bureau of Land & Water Resources
<i>Red Sand</i>	<i>20</i>	<i>105</i>	
<i>Orange Sand &amp; gravel</i>	<i>105</i>	<i>120</i>	

IF MORE SPACE IS NEEDED, USE BACK

If well telescopes please sketch and show depths.

GROUND LEVEL

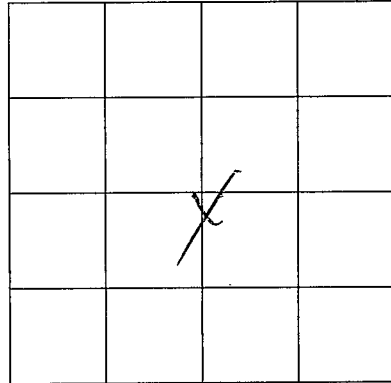

SECTION 10

Please indicate well location X.

ADDITIONAL INFORMATION

If more than one screen,  
show location of each on sketch.