

**MISSISSIPPI DEPARTMENT OF ENVIRONMENTAL QUALITY**  
Bureau of Land and Water Resources

P. O. Box 10631  
Jackson, MS 39289-0631  
**WATER WELL DRILLERS LOG**

COUNTY WELL LOCATED <b>WATKIN</b>	
WELL NUMBER <b>H</b>	CODED
DATE WELL COMPLETED <b>3/5/94</b>	

PERMIT NUMBER <b>0-508</b>
NAME OF DRILLING FIRM <b>Jordan Well Ser.</b>

NAME & MAILING ADDRESS OF LANDOWNER <b>W. R. CAPLAN</b>			
<b>26 Dillion Bridge Rd</b>			
<b>Tylertown, Miss.</b>			
WELL LOCATION:	SEC	TOWNSHIP	RANGE
	<b>1</b>	<b>1</b>	<b>10</b>
		<b>N</b>	<b>E</b>
		<b>S</b>	<b>W</b>
DISTANCE	DIRECTION	NEAREST TOWN	
<b>5</b>	<b>S</b>	<b>of Tylertown</b>	
OTHER LANDMARK			
WELL PURPOSE: Home, Irrigation, Municipal, Industrial, <u>Fish Pond</u> etc.			

<b>PUMP DATA</b>		
PUMP TYPE (Circle One): Submersible, Turbine, Jet <u>Flowing Well</u> Other (Describe) _____		
POWER TYPE (Circle One): Electric, Tractor, Diesel, Gasoline, Butane, Other (Describe) _____ H/P _____		
Pump Capacity (GPM)	No. of Stages	Setting Depth
		FT.
PUMP TEST		
Well yielded _____ GPM with		
a drawdown of _____ ft.		
after _____ hours of pumping		

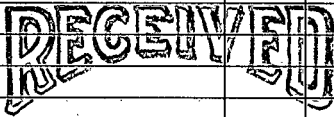
<b>WELL DATA</b>		
Well Depth <b>220</b>	Casing Diameter (In.) <b>2"</b>	Casing Length (Ft.) <b>200</b>
Type of Casing <b>PVC</b>	Hole Depth <b>220</b>	Depth to Static Water Level <b>Flow</b>
TYPE OF COMPLETION: (Circle One or More): Gravel Packed, Underreamed, Telescoped, Natural Development, Open Hole, Other (Describe) <b>40 ft. cement Grout</b>		
Top of Lap Pipe or Reduction in Casing:		
FEET	IF TELESCOPED OR MORE THAN ONE SCREEN: USE BACK PAGE	

<b>LOG DATA</b>	
TYPE OF LOG RUN (Circle One): No Log Run, Electric, Gamma Ray, Density, Sonic, Neutron, Other (Describe) _____	
Name of Organization Running Log	

<b>SCREEN DATA</b>		
Diameter - Inches <b>2</b>	Length - Feet <b>20</b>	Slot Size - Inches <b>.012</b>
Screen Type <b>PVC</b>	Depth to Bottom - Feet <b>200</b>	

<b>GEOLOGIC DATA (Office Use Only)</b>			
Surface Elev.	Geologic Unit	Unit Thickness	Depth to Top
Subs. SWL	Date	Analysis	Aquifer Test

Driller's Remarks

DESCRIPTION OF FORMATIONS ENCOUNTERED	FROM	TO	FORMATIONS (Continued)	FROM	TO
<b>Top Soil</b>	<b>0</b>	<b>1</b>	 <b>APR 01 1994</b> Dept. of Environmental Quality Office of Land & Water Resources		
<b>SAND clay</b>	<b>1</b>	<b>8</b>			
<b>SAND &amp; GRAVEL</b>	<b>8</b>	<b>50</b>			
<b>SHALE</b>	<b>50</b>	<b>160</b>			
<b>SAND</b>	<b>160</b>	<b>220</b>			

IF MORE SPACE IS NEEDED, USE BACK

