

**MISSISSIPPI DEPARTMENT OF NATURAL RESOURCES**  
**Bureau of Land and Water Resources**  
 Southport Mall  
 P.O. Box 10631  
 Jackson, Mississippi 39209  
**WATER WELL DRILLERS LOG**

Waltham  
H 2099

12-7- date well completed      19 46 Harold Woodward firm name      WALTHAM county well located

LANDOWNER: A. BAUGHMAN  
Elmer MA9EE RD  
Tylertown, MS,  
 (mailing address)

WELL LOCATION:  
 sec. 36 T. 1 N. R. 10 E.  
12 miles SE of Tylertown  
 (distance) (direction) (nearest town)

WELL PURPOSE: Home  
 (home, irrigation, municipal, industrial)


- WELL COMPLETION DATA:
- (1) diameter (inches) 4"
  - (2) total depth (feet) 208
  - (3) static water level (feet) 128' below above top of ground.
  - (4) casing PVC 198'  
 (material) (depth)  
 (size) if telescope see back.
  - (5) screen 10 198FT  
 (length) (depth to top)  
4" PVC  
 (size) (material)
  - (6) pump 1/2 10  
 (HP) (yield gpm)  
230V AC  
 (type power)
  - (7) electric log NO  
 (yes or no)  
SELF  
 (organization running log)
  - (8) how well bottom plugged PVC  
FLOP BACK WASH

description of formations encountered	from	to
<u>RED CLAY</u>	<u>0</u>	<u>28'</u>
<u>PINK SAND</u>	<u>28'</u>	<u>43'</u>
<u>White CLAY</u>	<u>43'</u>	<u>65'</u>
<u>Fine SAND w/ dry GRAVEL</u>	<u>65'</u>	<u>95'</u>
<u>PURPLE CLAY</u>	<u>95'</u>	<u>160'</u>
<u>Mixed SAND</u>	<u>165'</u>	<u>175'</u>
<u>CHONSB SAND WITH MED. GRAVEL</u>	<u>175'</u>	<u>210'</u>
<u>WELL SET</u>		
<u>AT 208 FT.</u>		
<u>DRILLER'S SIGNATURE</u>		
<u>JAN 13 1997</u>		
<u>Dept. of Environmental Quality</u> <u>Office of Land &amp; Water Resources</u>		

DRILLERS REMARKS:

If well telescopes please sketch and show depths.

GROUND LEVEL

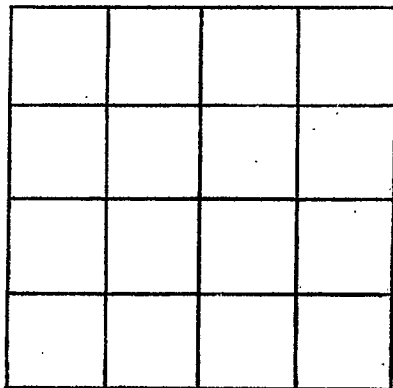

SECTION \_\_\_\_\_

Please indicate well location X.

ADDITIONAL INFORMATION

If more than one screen,  
show locations of each on sketch.