

MISSISSIPPI DEPARTMENT OF ENVIRONMENTAL QUALITY

Office of Land and Water Resources

P. O. Box 10631
Jackson, MS 39289-0631
WATER WELL DRILLERS LOG

COUNTY WELL LOCATED
Waltham

WELL NUMBER CODED
A 2123

DATE WELL COMPLETED
1-19-99

PERMIT NUMBER

NAME OF DRILLING FIRM
Fitzgerald Well

NAME & MAILING ADDRESS OF LANDOWNER
Stan Genovese
Brockdale Rd Tylertown

WELL LOCATION: SEC 19 TOWNSHIP 1 RANGE 10 W

DISTANCE 3 Miles DIRECTION West of NEAREST TOWN Lexie

OTHER LANDMARK

WELL PURPOSE: Home Irrigation, Municipal, Industrial, Fish Pond, etc.

PUMP DATA

PUMP TYPE (Circle One):
Submersible, Turbine, Jet, Flowing Well,
Other (Describe)

POWER TYPE (Circle One):
Electric, Turbine, Diesel, Gasoline, Butane,
Other (Describe) H/P 1

Pump Capacity (GPM)	No. of Stages	Setting Depth
<u>18</u>	<u>8</u>	<u>120</u> FT.

PUMP TEST

Well yielded _____ GPM with
a drawdown of _____ ft.
after _____ hours of pumping

WELL DATA

Well Depth <u>198'</u>	Casing Diameter (In.) <u>4"</u>	Casing Length (Ft.) <u>178'</u>
Type of Casing <u>PVC</u>	Hole Depth <u>198'</u>	Depth to Static Water Level <u>75'</u>

TYPE OF COMPLETION: (Circle One or More):
Gravel Packed, Underreamed, Telescoped,
Natural Development, Open Hole, Other

WELL GROUTED TO A DEPTH OF 10 FEET
Type Grout (circle one): Cement, Bentonite, or Mix

LOG DATA

TYPE OF LOG RUN (Circle One): No Log Run,
Electric, Gamma Ray, Density, Sonic, Neutron,
Other (Describe)

Name of Organization Running Log

SCREEN DATA

Diameter - Inches <u>4"</u>	Length - Feet <u>20</u>	Slot Size - Inches <u>.012</u>
Screen Type <u>PVC</u>	Depth to Bottom - Feet <u>198'</u>	


GEOLOGIC DATA (Office Use Only)

Surface Elev.	Geologic Unit	Unit Thickness	Depth to Top
Subs. SWL	Date	Analysis	Aquifer Test

Driller's Remarks

Top of Lap Pipe or Reduction in Casing


FEET IF TELESKOPED OR MORE THAN ONE SCREEN: USE BACK PAGE

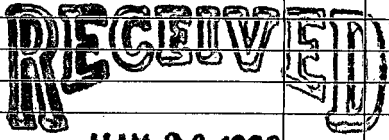DESCRIPTION OF FORMATIONS ENCOUNTERED	FROM	TO	FORMATIONS (Continued)	FROM	TO
<u>Top Soil</u>	<u>0</u>	<u>5</u>	 MAY 26 1999 Dept. of Environmental Quality Office of Land & Water Resources		
<u>gravel</u>	<u>5</u>	<u>15</u>			
<u>clay</u>	<u>15</u>	<u>40</u>			
<u>Sand & gravel</u>	<u>40</u>	<u>80</u>			
<u>clay</u>	<u>80</u>	<u>160</u>			
<u>Fine sand</u>	<u>160</u>	<u>170</u>			
<u>coarse sand & gravel</u>	<u>170</u>	<u>198</u>			

IF MORE SPACE IS NEEDED, USE BACK

If well telescopes please sketch and show depths.

GROUND LEVEL

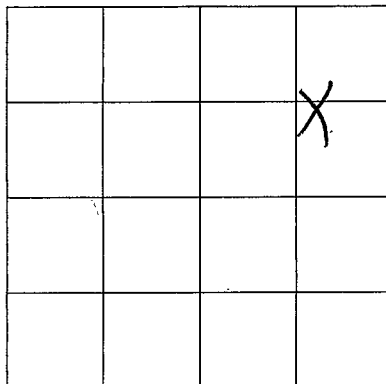

SECTION _____

Please indicate well location X.

ADDITIONAL INFORMATION

If more than one screen,
show location of each on sketch.