

MISSISSIPPI DEPARTMENT OF ENVIRONMENTAL QUALITY

Office of Land and Water Resources

P. O. Box 10631
Jackson, MS 39289-0631

WATER WELL DRILLERS LOG

COUNTY WELL LOCATED
Walshall

WELL NUMBER H2129 CODED

DATE WELL COMPLETED
11-13-99

PERMIT NUMBER
0-621

NAME OF DRILLING FIRM
Daniel Boone

Tylertown, Ms.

NAME & MAILING ADDRESS OF LANDOWNER
Brent Boyd

84 Hinson Rd.

Tylertown, Ms.

WELL LOCATION SEC 6 TOWNSHIP 1 RANGE 10 W

DISTANCE 4 Miles DIRECTION W of NEAREST TOWN Lexie

OTHER LANDMARK

WELL PURPOSE: Home Irrigation; Municipal; Industrial; Fish Pond, etc.

PUMP DATA

PUMP TYPE (Circle One):
Submersible, Turbine, Jet Flowing Well
Other (Describe)

POWER TYPE (Circle One):
Electric, Tractor, Diesel, Gasoline, Butane,
Other (Describe) H/P

Pump Capacity (GPM) No. of Stages Setting Depth FT.

PUMP TEST

Well yielded 40 GPM with
a drawdown of _____ ft.
after _____ hours of pumping

WELL DATA

Well Depth <u>185'</u>	Casing Diameter (In.) <u>4"</u>	Casing Length (Ft.) <u>1165'</u>
Type of Casing <u>PVC</u>	Hole Depth <u>187'</u>	Depth to Static Water Level

TYPE OF COMPLETION: (Circle One or More):
 Gravel Packed, Underreamed, Telescoped,
 Natural Development, Open-Hole, Other
(Describe)

WELL GROUTED TO A DEPTH OF 9 FEET
Type Grout (circle one): Cement, Bentonite, or Mix

LOG DATA

TYPE OF LOG RUN (Circle One):
No Log Run, Electric, Gamma Ray, Density, Sonic, Neutron,
Other (Describe)

Name of Organization Running Log

SCREEN DATA

Diameter - Inches <u>4"</u>	Length - Feet <u>20'</u>	Slot-Size - Inches <u>.008</u>
Screen Type <u>PVC Sch. 40</u>	Depth to Bottom - Feet <u>2'</u>	

GEOLOGIC DATA (Office Use Only)

Surface Elev.	Geologic Unit	Unit Thickness	Depth to Top
Subs. SWL	Date	Analysis	Aquifer Test

Driller's Remarks

Top of Lap Pipe or Reduction in Casing


FEET IF TELESCOPED OR MORE THAN ONE SCREEN: USE BACK PAGE

DESCRIPTION OF FORMATIONS ENCOUNTERED	FROM	TO	FORMATIONS (Continued)	FROM	TO
<u>Clay</u>	<u>0</u>	<u>9</u>			
<u>Pea Gravel</u>	<u>9</u>	<u>18</u>			
<u>Sand</u>	<u>18</u>	<u>85</u>			
<u>Clay</u>	<u>85</u>	<u>130</u>			
<u>Sand</u>	<u>130</u>	<u>185</u>			

IF MORE SPACE IS NEEDED, USE BACK

If well telescopes please
sketch and show depths.

GROUND LEVEL

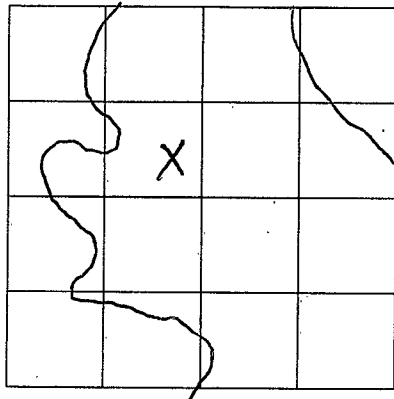

SECTION

6

Please indicate well location X.

ADDITIONAL INFORMATION

If more than one screen,
show location of each on sketch.