

**MISSISSIPPI DEPARTMENT OF ENVIRONMENTAL
QUALITY**
Office of Land and Water Resources

P. O. Box 10631
Jackson, MS 39289-0631
WATER WELL DRILLERS LOG

COUNTY WELL LOCATED Walthall	
WELL NUMBER H2130	CODED
DATE WELL COMPLETED 11-11-99	

PERMIT NUMBER 0-621
NAME OF DRILLING FIRM Daniel Boone
Tylertown, Ms.

NAME & MAILING ADDRESS OF LANDOWNER Richard Estess			
Carriere, Ms.			
WELL LOCATION	SEC	TOWNSHIP	RANGE
	6	1	10
		N	W
DISTANCE	DIRECTION	NEAREST TOWN	
4 Miles	W	of Lexie	
OTHER LANDMARK			
WELL PURPOSE <input checked="" type="checkbox"/> Home Irrigation, Municipal, Industrial, Fish Pond, etc.			

PUMP DATA		
PUMP TYPE (Circle One): Submersible, Turbine, Jet <input checked="" type="checkbox"/> Flowing Well Other (Describe) _____		
POWER TYPE (Circle One): Electric, Tractor, Diesel, Gasoline, Butane, Other (Describe) _____ H/P _____		
Pump Capacity (GPM)	No. of Stages	Setting Depth FT.
PUMP TEST		
Well yielded 25 GPM with a drawdown of _____ ft. after _____ hours of pumping		

WELL DATA		
Well Depth 182'	Casing Diameter (In.) 4"	Casing Length (Ft.) 1162'
Type of Casing PVC	Hole Depth 184'	Depth to Static Water Level
TYPE OF COMPLETION: (Circle One or More): <input checked="" type="checkbox"/> Gravel Packed, <input type="checkbox"/> Underreamed, <input type="checkbox"/> Telescoped, <input type="checkbox"/> Natural Development, <input type="checkbox"/> Open Hole, <input type="checkbox"/> Other (Describe) _____		

LOG DATA	
TYPE OF LOG RUN (Circle One): Electric, Gamma Ray, Density, Sonic, Neutron, Other (Describe) _____ <input checked="" type="checkbox"/> No Log Run	
Name of Organization Running Log	

WELL GROUTED TO A DEPTH OF **8** FEET
Type Grout (circle one): Cement, Bentonite, or Mix

GEOLOGIC DATA (Office Use Only)			
Surface Elev.	Geologic Unit	Unit Thickness	Depth to Top
Subs. SWL	Date	Analysis	Aquifer Test

SCREEN DATA		
Diameter - Inches 4"	Length - Feet 20'	Slot Size - Inches .008
Screen Type PVC Sch. 40		Depth to Bottom - Feet 2'

Driller's Remarks


Top of Lap Pipe or Reduction in Casing

FEET IF TELESKOPED OR MORE THAN ONE SCREEN USE BACK PAGE

DESCRIPTION OF FORMATIONS ENCOUNTERED	FROM	TO	FORMATIONS (Continued)	FROM	TO
Clay	0	8			
Pea Gravel	8	25			
Sand	25	70			
Clay	70	125			
Sand	125	182			

If well telescopes please sketch and show depths.

GROUND LEVEL

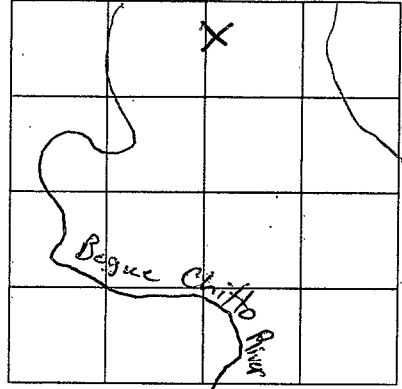

SECTION Co

Please indicate well location X.

ADDITIONAL INFORMATION

If more than one screen,
show location of each on sketch.