

MISSISSIPPI DEPARTMENT OF ENVIRONMENTAL QUALITY

Office of Land and Water Resources

P. O. Box 10631
Jackson, MS 39289-0631
WATER WELL DRILLERS LOG

COUNTY WELL LOCATED <u>Walthall</u>	
WELL NUMBER <u>H-2134</u>	CODED
DATE WELL COMPLETED <u>5-12-00</u>	

PERMIT NUMBER <u>0-621</u>
NAME OF DRILLING FIRM <u>Daniel Boone</u>


NAME & MAILING ADDRESS OF LANDOWNER <u>Bobby McGinnis</u>		
<u>Old River Rd</u>		
<u>Tylertown MS</u>		
WELL LOCATION: SEC. <u>07</u> TOWNSHIP <u>1 S</u> RANGE <u>10 W</u>		
DISTANCE <u>6</u> Miles	DIRECTION <u>SW</u>	NEAREST TOWN <u>Tylertown</u>
OTHER LANDMARK		
WELL PURPOSE <u>Home, Irrigation</u> Municipal, Industrial, Fish Pond, etc.		

PUMP DATA		
PUMP TYPE (Circle One): Submersible, Turbine, Jet <u>Flowing Well</u> Other (Describe)		
POWER TYPE (Circle One): Electric, Tractor, Diesel, Gasoline, Butane, Other (Describe) H/P		
Pump Capacity (GPM)	No. of Stages	Setting Depth
		FT.
PUMP TEST		
Well yielded <u>40</u> GPM with		
a drawdown of _____ ft.		
after _____ hours of pumping		

WELL DATA		
Well Depth <u>180</u>	Casing Diameter (In.) <u>4"</u>	Casing Length (Ft.) <u>160</u>
Type of Casing <u>PVC</u>	Hole Depth <u>180</u>	Depth to Static Water Level <u>Flowing</u>
TYPE OF COMPLETION: (Circle One or More): <u>Gravel Packed</u> , Underreamed, Telescoped, Natural Development, Open Hole, Other (Describe)		
WELL GROUTED TO A DEPTH OF <u>10</u> FEET Type Grout (circle one): <u>Cement</u> , Bentonite, or Mix		

LOG DATA	
TYPE OF LOG RUN (Circle One): Electric, Gamma Ray, Density, Sonic, Neutron, Other (Describe) <u>No Log Run</u>	
Name of Organization Running Log	

SCREEN DATA		
Diameter - Inches <u>4"</u>	Length - Feet <u>20'</u>	Slot Size - Inches <u>.008</u>
Screen Type <u>PVC Sch. 40</u>	Depth to Bottom - Feet: <u>0</u>	


GEOLOGIC DATA (Office Use Only)			
Surface Elev.	Geologic Unit	Unit Thickness	Depth to Top
Subs. SWL	Date	Analysis	Aquifer Test
Driller's Remarks			
Top of Lap Pipe or Reduction in Casing			
			

DESCRIPTION OF FORMATIONS ENCOUNTERED	FROM	TO
<u>CLAY</u>	<u>0</u>	<u>35</u>
<u>Sand</u>	<u>35</u>	<u>68</u>
<u>CLAY</u>	<u>68</u>	<u>140</u>
<u>Sand</u>	<u>140</u>	<u>180</u>

FORMATIONS (Continued)	TO
<u>AUG 07 2000</u>	
Dept. of Environmental Quality Office of Land & Water Resources	
IF MORE SPACE IS NEEDED, USE BACK	

If well telescopes please sketch and show depths.

GROUND LEVEL

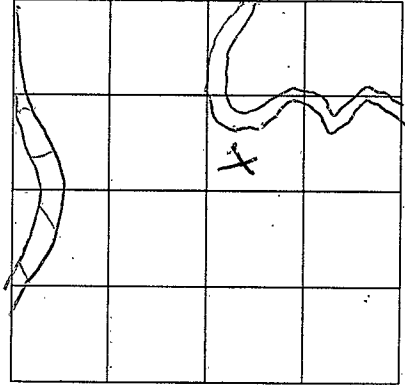

SECTION 7

Please indicate well location X.

ADDITIONAL INFORMATION

Lined area for providing additional information.

WATER RESOURCES DIVISION
STATE OF TEXAS
DALLAS, TEXAS

If more than one screen, show location of each on sketch.