

MISSISSIPPI DEPARTMENT OF ENVIRONMENTAL QUALITY

Office of Land and Water Resources

P. O. Box 10631

Jackson, MS 39289-0631

WATER WELL DRILLERS LOG

COUNTY WELL LOCATED  
~~Walthall~~ Walthall  
 WELL NUMBER H-2137 CODED  
 DATE WELL COMPLETED  
7-24-00

PERMIT NUMBER  
0-621  
 NAME OF DRILLING FIRM  
Daniel Boone

NAME & MAILING ADDRESS OF LANDOWNER  
Joe Fortenberry  
621 Stallions Blvd. Rd  
Tylertown, MS  
 WELL LOCATION: SEC. 12 TOWNSHIP. 1 RANGE 9  
 DISTANCE 9 Miles DIRECTION SW of NEAREST TOWN Tylertown  
 OTHER LANDMARK  
 WELL PURPOSE Home, Irrigation, Municipal, Industrial, Fish Pond, etc.

PUMP DATA  
 PUMP TYPE (Circle One):  
 Submersible, Turbine, Jet, Flowing Well,  
 Other (Describe)  
 POWER TYPE (Circle One):  
 Electric, Tractor, Diesel, Gasoline, Butane,  
 Other (Describe) H/P 2 HP  
 Pump Capacity (GPM) 28 No. of Stages Setting Depth 155 FT.  
 PUMP TEST  
 Well yielded 38 GPM with  
 a drawdown of 35 ft.  
 after 12 hours of pumping

WELL DATA  
 Well Depth 205 Casing Diameter (In) 4" Casing Length (Fl.) 165'  
 Type of Casing PVC Hole Depth 205 Depth to Static Water Level 105'

LOG DATA  
 TYPE OF LOG RUN (Circle One):  
 No Log Run  
 Electric, Gamma Ray, Density, Sonic, Neutron,  
 Other (Describe)  
 Name of Organization Running Log

TYPE OF COMPLETION: (Circle One or More):  
 Gravel Packed, Underreamed, Telescoped,  
 Natural Development, Open Hole, Other  
 (Describe)  
 WELL GROUTED TO A DEPTH OF 9 FEET  
 Type Grout (circle one)  Cement, Bentonite, or Mix

GEOLOGIC DATA (Office Use Only)  

Surface Elev.	Geologic Unit	Unit Thickness	Depth to Top
Subs. SWL	Date	Analysis	Aquifer Test

SCREEN DATA  
 Diameter - Inches 4" Length - Feet 40' Slot Size - Inches .008  
 Screen Type PVC Sch. 40 Depth to Bottom - Feet 2'


Driller's Remarks  
 Top of Lap Pipe or Reduction in Casing  
 IF TELESKOPED OR MORE THAN 10 FEET ON SCREEN, USE BACK PAGE

DESCRIPTION OF FORMATIONS ENCOUNTERED	FROM	TO
Clay	0	18
Sand	18	40
Large Gravel	40	90
Sand	90	105
Clay	105	118
Sand	118	205

FORMATIONS (Continued) FROM TO  
 AUG 07 2000  
 Dept. of Environmental Quality  
 Office of Land & Water Resources  
 IF MORE SPACE IS NEEDED, USE BACK

If well telescopes please sketch and show depths.

GROUND LEVEL

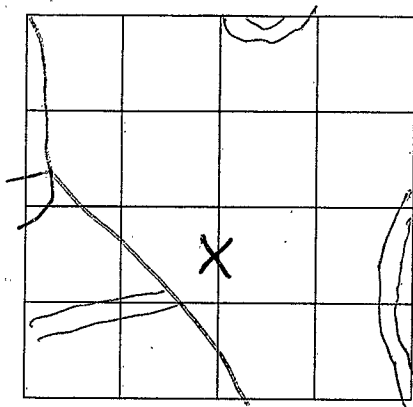

SECTION 12

Please indicate well location X.

ADDITIONAL INFORMATION

*[Faint, illegible text or stamp, possibly a date or reference number]*

If more than one screen, show location of each on sketch.