

MISSISSIPPI DEPARTMENT OF ENVIRONMENTAL QUALITY

Office of Land and Water Resources

P. O. Box 10631
Jackson, MS 39289-0631
WATER WELL DRILLERS LOG

COUNTY WELL LOCATED
Washington

WELL NUMBER CODED

H 2141

DATE WELL COMPLETED
3-21-00

PERMIT NUMBER

NAME OF DRILLING FIRM
 Fitzgerald Well Service

NAME & MAILING ADDRESS OF LANDOWNER
Bobby Grow

413 Claude Smith Rd., Tyler, LA

WELL LOCATION: SEC 5 TOWNSHIP 1 RANGE 10
S N E
W

DISTANCE 5 Miles DIRECTION SW of NEAREST TOWN Tylertown

OTHER LANDMARK

WELL PURPOSE: Home Irrigation, Municipal, Industrial, Fish Pond, etc.

PUMP DATA

PUMP TYPE (Circle One):
 Submersible, Turbine, Jet, Flowing Well,
Other (Describe) _____

POWER TYPE (Circle One):
 Electric, Tractor, Diesel, Gasoline, Butane,
Other (Describe) _____ H/P 34

Pump Capacity (GPM) No. of Stages Setting Depth
12 12 100' FT.

PUMP TEST

Well yielded _____ GPM with
a drawdown of _____ ft.
after _____ hours of pumping

WELL DATA

Well Depth <u>150</u>	Casing Diameter (In.) <u>4"</u>	Casing Length (Ft.) <u>140'</u>
Type of Casing <u>PVC</u>	Hole Depth <u>150'</u>	Depth to Static Water Level <u>94'</u>

TYPE OF COMPLETION: (Circle One or More):
 Gravel Packed, Underreamed, Telescoped,
 Natural Development, Open Hole, Other
(Describe) _____

LOG DATA

TYPE OF LOG RUN (Circle One):
 No Log Run, Electric, Gamma Ray, Density, Sonic, Neutron,
Other (Describe) _____

Name of Organization Running Log

WELL GROUTED TO A DEPTH OF 10 FEET
Type Grout (circle one): Cement, Bentonite, Mix

GEOLOGIC DATA (Office Use Only)

Surface Elev.	Geologic Unit	Unit Thickness	Depth to Top
Subs. SWL	Date	Analysis	Aquifer Test

SCREEN DATA

Diameter - Inches <u>4"</u>	Length - Feet <u>10</u>	Slot Size - Inches <u>.012</u>
Screen Type <u>PVC</u>	Depth to Bottom - Feet <u>150'</u>	

Driller's Remarks

Top of Lap Pipe or Reduction in Casing

FEET IF TELESCOPED OR MORE THAN ONE SCREEN: USE BACK PAGE

DESCRIPTION OF FORMATIONS ENCOUNTERED	FROM	TO
<u>Clay & gravel</u>	<u>0</u>	<u>60</u>
<u>sand</u>	<u>60</u>	<u>90</u>
<u>Clay</u>	<u>90</u>	<u>120</u>
<u>sand</u>	<u>120</u>	<u>140</u>
<u>coarse sand</u>	<u>140</u>	<u>150</u>


FORMATIONS (Continued)	FROM	TO

REC'D JUN 21 2001

IF MORE SPACE IS NEEDED, USE BACK

If well telescopes please sketch and show depths.

GROUND LEVEL

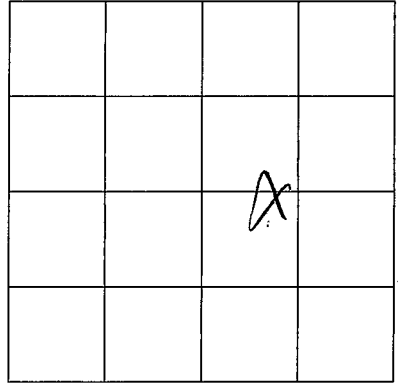

SECTION 5

Please indicate well location X.

ADDITIONAL INFORMATION

If more than one screen,
show location of each on sketch.