

WALTHALL MISSISSIPPI BOARD OF WATER COMMISSIONERS

J 6

11-29-61

INDEXED

WATER WELL DRILLERS LOG

✓

Date: 11-29, 1961, Driller: Chester Reeves, County: Walthall


(Name)

(1) Owner of Land:	Description & Color of Materials Sand, Clay, Red Clay, Shell, etc.	Thick- ness Feet
Docho Thomas (Name)	yellow clay	16
RFD - Tyler town (Address)	red sand	9
(2) Location: 1/4, 1/4, Sec. 26 T. 1 R. 11,	red clay & sand	15
10 miles S.E. of Tyler town (distance) (direction) (Nearest Town)	yellow sand	25
(3) Topography: hilly (Hilly) (Flat) (Level)	red gravel	11
(4) Purpose of Well: Domestic (Domestic Irrigation Municipal, Industrial, Other)	white chalk	27
	fine white sand	52
	coarse pink sand	10
		165

Information upon completion of well:

- (1) Diameter 4 inches.
- (2) Total Depth 165 feet.
- (3) Water Level 71 feet below top of ground.
- (4) Cased to Bottom, Size 4'
- (5) Screen: Size 4", Length 3ft.
- (6) Were any formations sealed against pollution?  
 yes,  no.

INDEXED

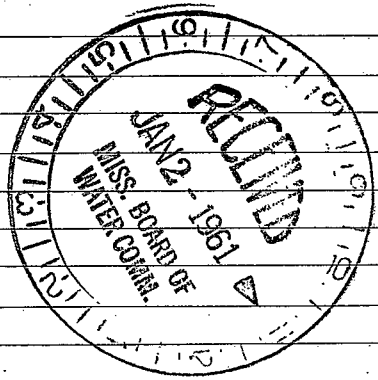

If YES depth of formation \_\_\_\_\_  
 Why \_\_\_\_\_

Drillers Remarks: all felt well cased in -

(Use Back Side)

[The page contains extremely faint and illegible text, likely bleed-through from the reverse side of the document. No specific words or phrases can be discerned.]