

WALTHALL  
J8  
10-71

MISSISSIPPI  
BOARD OF WATER COMMISSIONERS  
416 North State Street  
Jackson, Mississippi 39201

WATER WELL DRILLERS LOG

**CODED**

Oct. 1971 E.B. SHERROD WALTHALL  
date well completed firm name county well located

LANDOWNER:	description of formations encountered	from	to
WALTER LEWIS TYLERTOWN, MISS. (mailing address)	BED SANDY CLAY BED SAND & GR. PAVING SMALL PEA GR.	0	30 120 140
WELL LOCATION: sec. 18 T-1 N R-11 E 4 miles S TYLERTOWN (distance) (direction) (nearest town)			
WELL PURPOSE: (home) Irrigation, municipal, industrial			
WELL COMPLETION DATA: (1) diameter (inches) 2" (2) total depth (feet) 140 (3) static water level (feet) 45 below above top of ground. (4) casing PL 135 (material) (depth) 2" (size) if telescope see back. (5) screen 5' (length) (depth to top) 2" (size) PL (material) (6) pump 3/4 (HP) 8 (yield gpm) E (type power) (7) electric log (yes or no) (organization running log) (8) how well bottom plugged BWV			
DRILLERS REMARKS:			


**CODED**

FFR - 2 1972

MISS. Bd. OF  
WATER COMM.

If well telescopes please sketch and show depths.

GROUND LEVEL

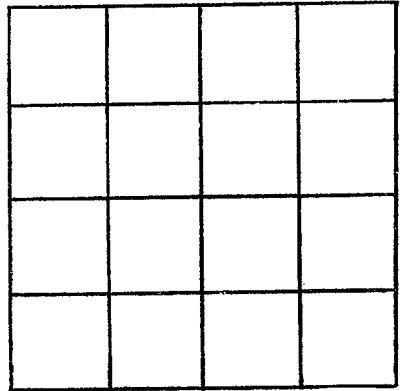

SECTION \_\_\_\_\_

Please indicate well location X.

ADDITIONAL INFORMATION

If more than one screen,  
show locations of each on sketch.