

WALTHAM, MISSISSIPPI BOARD OF WATER COMMISSIONERS

J 10

5-3-66


**CODED**

WATER WELL DRILLERS LOG

Date: 5/3, 1966, Driller: T. B. Andrews County Waltham

(Name)

(1) Owner of Land: <u>Robert Bryant</u> (Name)	Description & Color of Materials Sand, Clay, Red Clay, Shell, etc.	Thick- ness Feet	Depth Feet
<u>rt. 4 Tulee town, Miss</u> (Address)			
(2) Location: <u>1/4</u> , <u>1/4</u> , Sec. <u>26</u> T1 <sup>N</sup> R11, <u>10</u> miles <u>SE.</u> , of <u>Tulee town</u> , (distance) (direction) (Nearest Town)	<u>0' to 40'</u> <u>Red Clay</u>		
(3) Topography: <u>Hilly</u> (Hilly) (Flat) (Level)	<u>40' to 60'</u> <u>Sand</u>		
(4) Purpose of Well: <u>Domestic</u> (Domestic, Irrigation, Municipal, Industrial, Other)	<u>60' to 62'</u> <u>GRAVEL</u>		
Information upon completion of well:			
(1) Diameter <u>4</u> inches.	<u>62' to 120'</u> <u>Chalk</u>		
(2) Total Depth <u>140</u> feet.	<u>120' to 130'</u> <u>Sand</u>		
(3) Water Level <u>120</u> feet below top of ground.	<u>130' to 140'</u> <b>CODED</b>		
(4) Cased to <u>140'</u> , Size <u>4"</u>	<u>Coarse Sand</u>		
(5) Screen: Size <u>4"</u> , Length <u>6'</u>	<u>&amp; GRAVEL</u>		
(6) Were any formations sealed against pollution? <u>no</u>			
If YES depth of formation _____			
Why _____			
Drillers Remarks: <u>Plastic Well</u>			

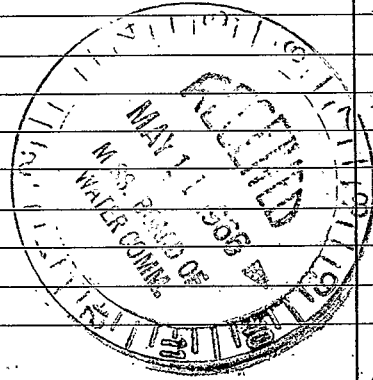

13

Well No.

(Use Back Side)

