

J 11
6-17-66

WATER WELL DRILLERS LOG

Date: 6/17/66, 1966, Driller: T. B. Andrews County Walthall
(Name)

(1) Owner of Land:	Description & Color of Materials	Thick-ness Feet	Depth Feet
<u>Mrs. Sam Thomas</u> (Name) <u>Rt. 7 Tybertown</u> (Address)	<u>0' to 20'</u> <u>Red Clay</u>		
(2) Location: <u>1/4</u> , <u>1/4</u> , Sec. <u>35 T1 R11</u> , <u>5</u> miles <u>SE</u> , of <u>Kirklin</u> (distance) (direction) (Nearest Town)	<u>20' to 80'</u> <u>Sand & Gravel</u>		
(3) Topography: <u>Hilly</u> (Hilly) (Flat) (Level)			
(4) Purpose of Well: <u>Domestic</u> (Domestic Irrigation Municipal, Industrial, Other)			

Information upon completion of well:

- (1) Diameter 2 inches.
- (2) Total Depth 80 feet.
- (3) Water Level 50 feet below top of ground.
- (4) Cased to 80', Size 2'
- (5) Screen: Size 2', Length 5'
- (6) Were any formations sealed against pollution?
_____ yes, _____ no.


If YES depth of formation _____

Why _____

Drillers Remarks:

2" Galvanized Well

CODED

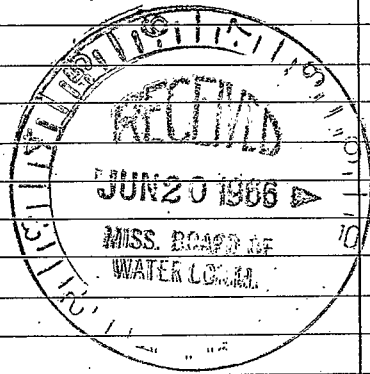

(Use Back Side)

Well No.

